


T.6S. R.2W. W.M.

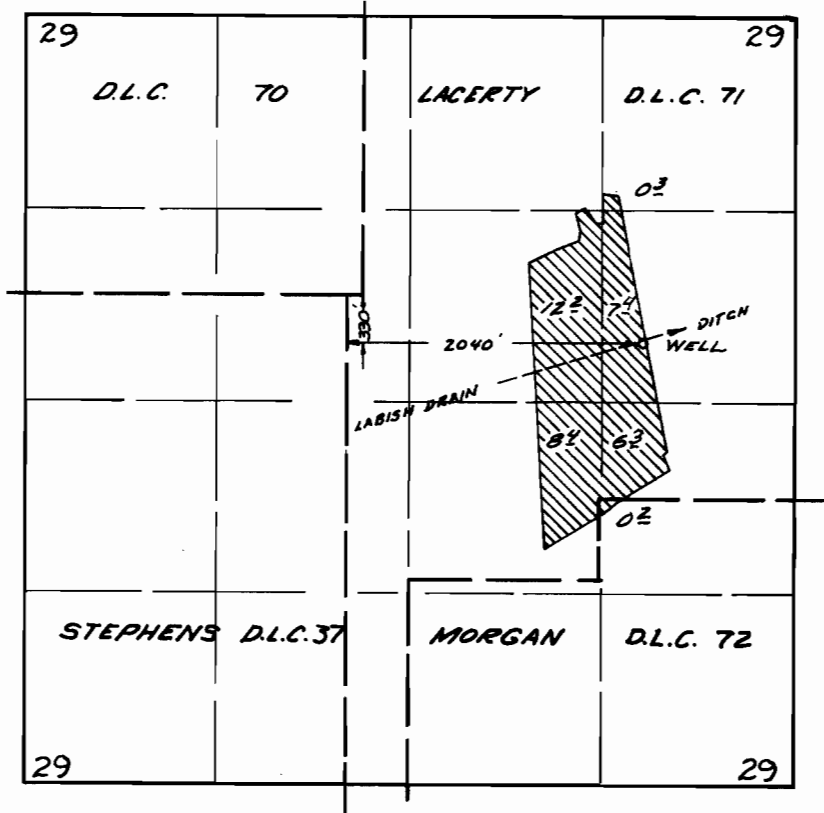

FINAL PROOF SURVEY UNDER

Application No. G-4037 Permit No. G-3785
IN NAME OF

JOHN LEE LESHER by IDA A. LESHER

Surveyed June 19 1968, by V. Garner