


T. 8 S. R. 3 W. W. M.

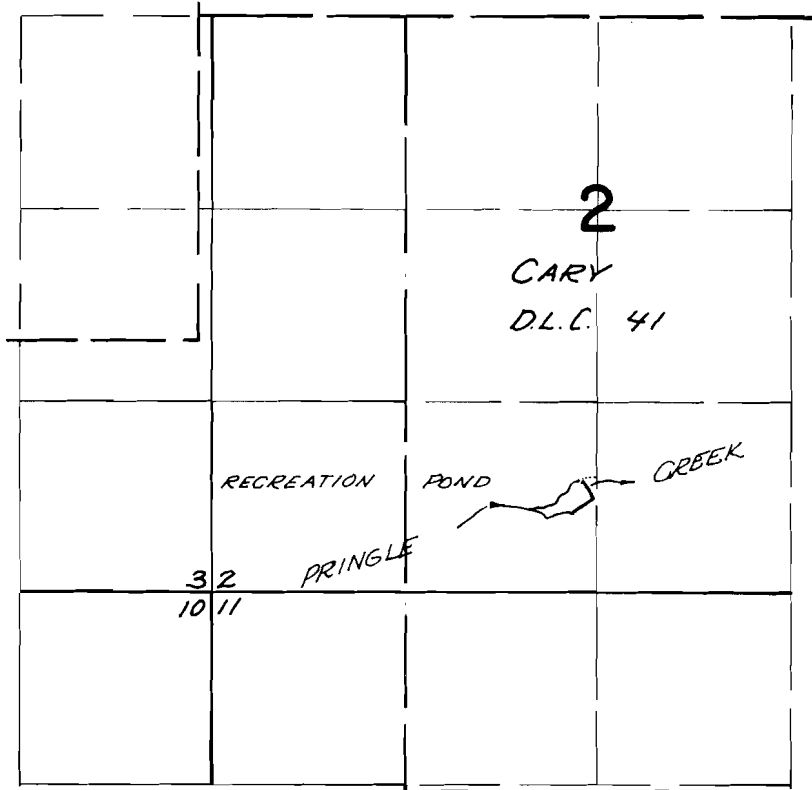

FINAL PROOF SURVEY
UNDER

Application No. *R-40728* Permit No. *R-4544*
IN NAME OF

OREGON FAIRVIEW HOME

Surveyed *April 26 1968*, by *V. GARNER*