


T.8S. R.3W. W.M.

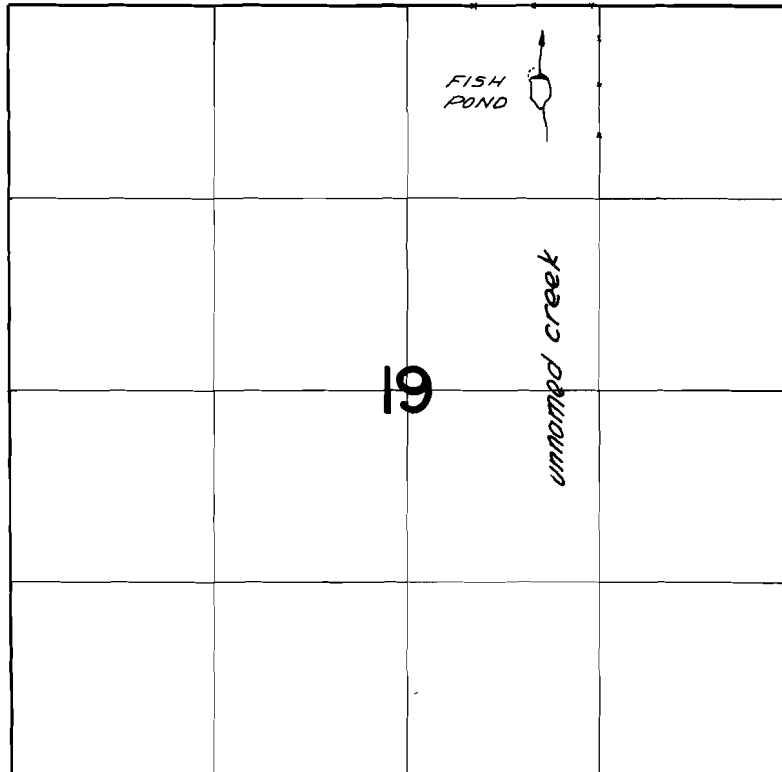

FINAL PROOF SURVEY
UNDER

Application No. *R-4213B* Permit No. *R-4698*
IN NAME OF

JAMES SCOTT BREMMER

Surveyed *April 26, 1968*, by *V. GARNER*