


T.7S. R.2W. W.M.

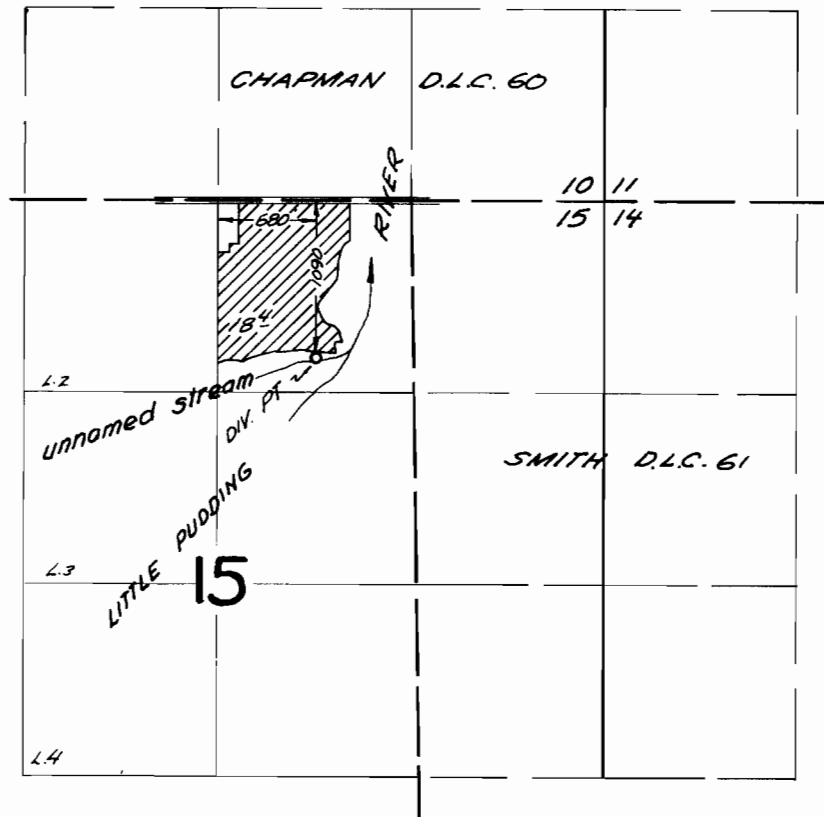

FINAL PROOF SURVEY
UNDER

Application No. 39503 Permit No. 29398
IN NAME OF

E. V. HAMMER

Surveyed May 9 1968, by V. GARNER