


T. 8 S. R. 3 W. W.M.

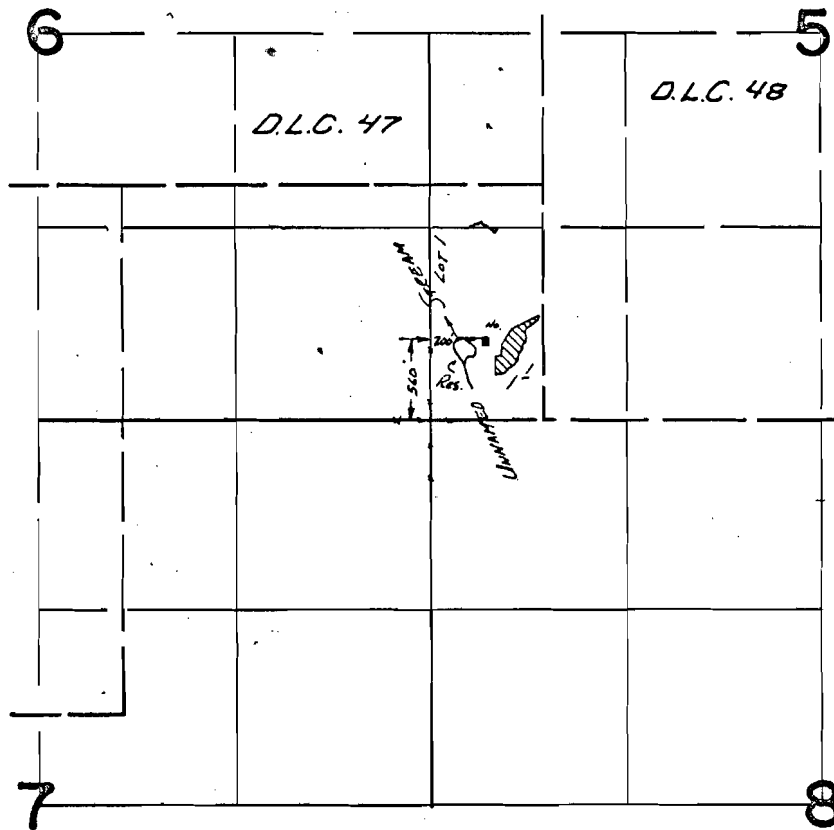

FINAL PROOF SURVEY
UNDER

Application No. ^{R-39653} ~~39654~~ ^{R-3955} Permit No. ~~29462~~
IN NAME OF

LEE BYERS

Surveyed April 23 1968, by V. GARNER