


T 7 S. R. 1 & 2 W. W. M.

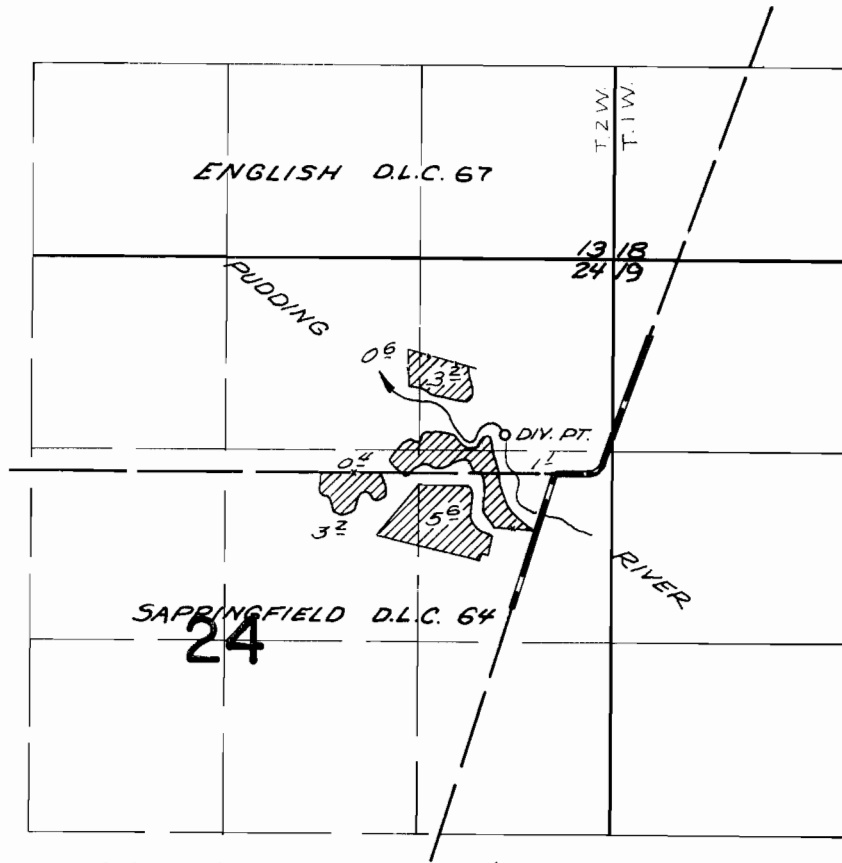

DIV. PT. LOCATED 270 FT. N. & 340 FT. W. FROM
THE N.E. COR. SAPPINGFIELD D.L.C. 64

FINAL PROOF SURVEY UNDER

Application No. 39737. Permit No. 29558
IN NAME OF

GERALD T. ODOM

Surveyed Aug. 16, 1968, by V. Garner