


T.7S.R.1E.W.M

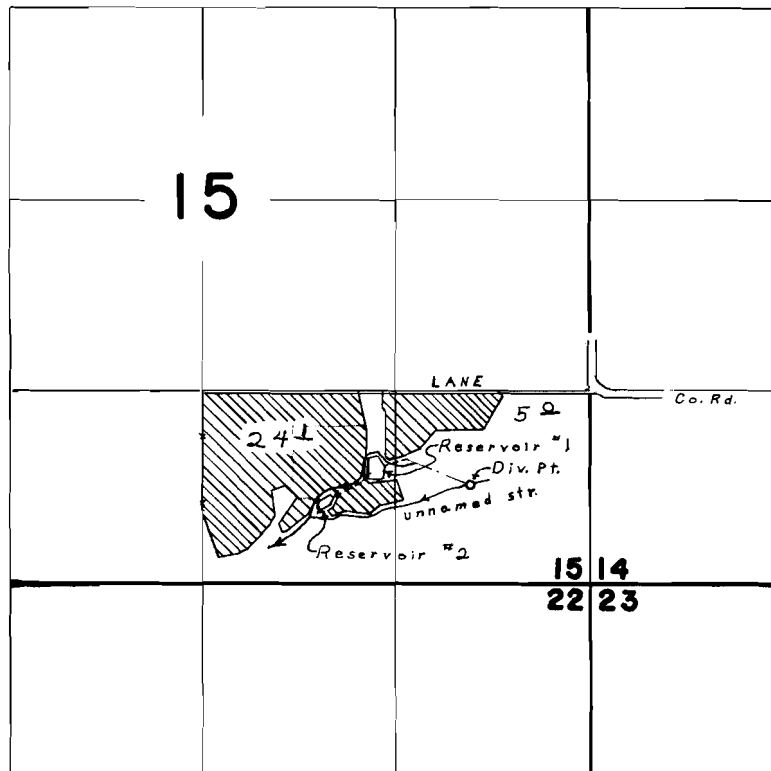

Div. Pts located: 560' S & 1130' E: 820' S & 790' E:  
640' S & 1830' E: from NW cor. SW  $\frac{1}{4}$ , SE  $\frac{1}{4}$

**FINAL PROOF SURVEY**  
UNDER

R-39994 R-4133  
Application No. 39995 Permit No. 29792  
IN NAME OF

**MR. MIRZA ALDEN WATERSON**

Surveyed **JULY 26 1968**, by **L. E. GOULD**