


T. 8 S. R. 4 E. W. M.

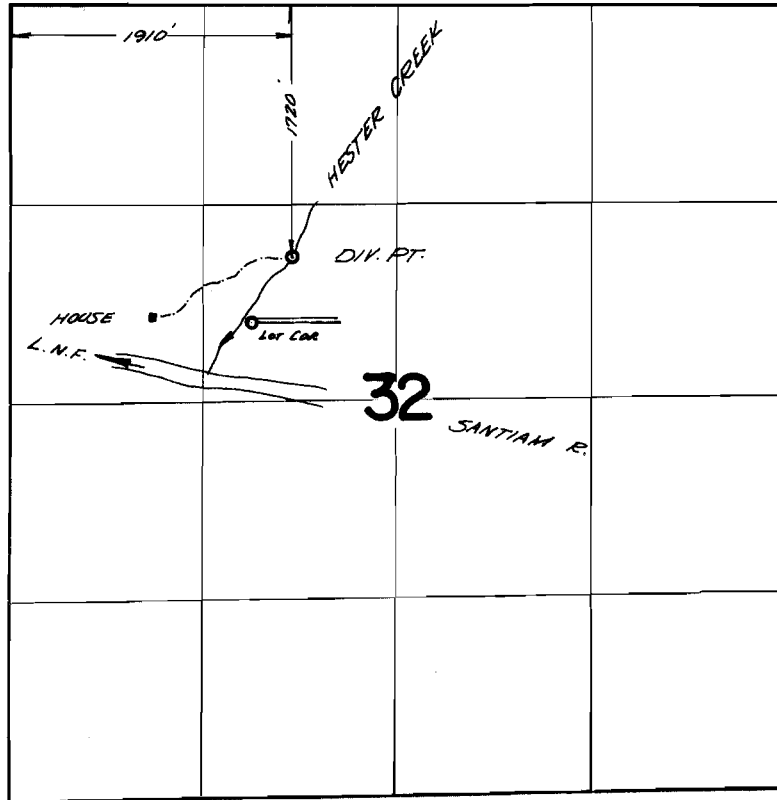

FINAL PROOF SURVEY UNDER

Application No. 40881 Permit No. 30474
IN NAME OF

..... HENRY W. BAKER

Surveyed Sept. 5, 1968, by V. Garner.....