
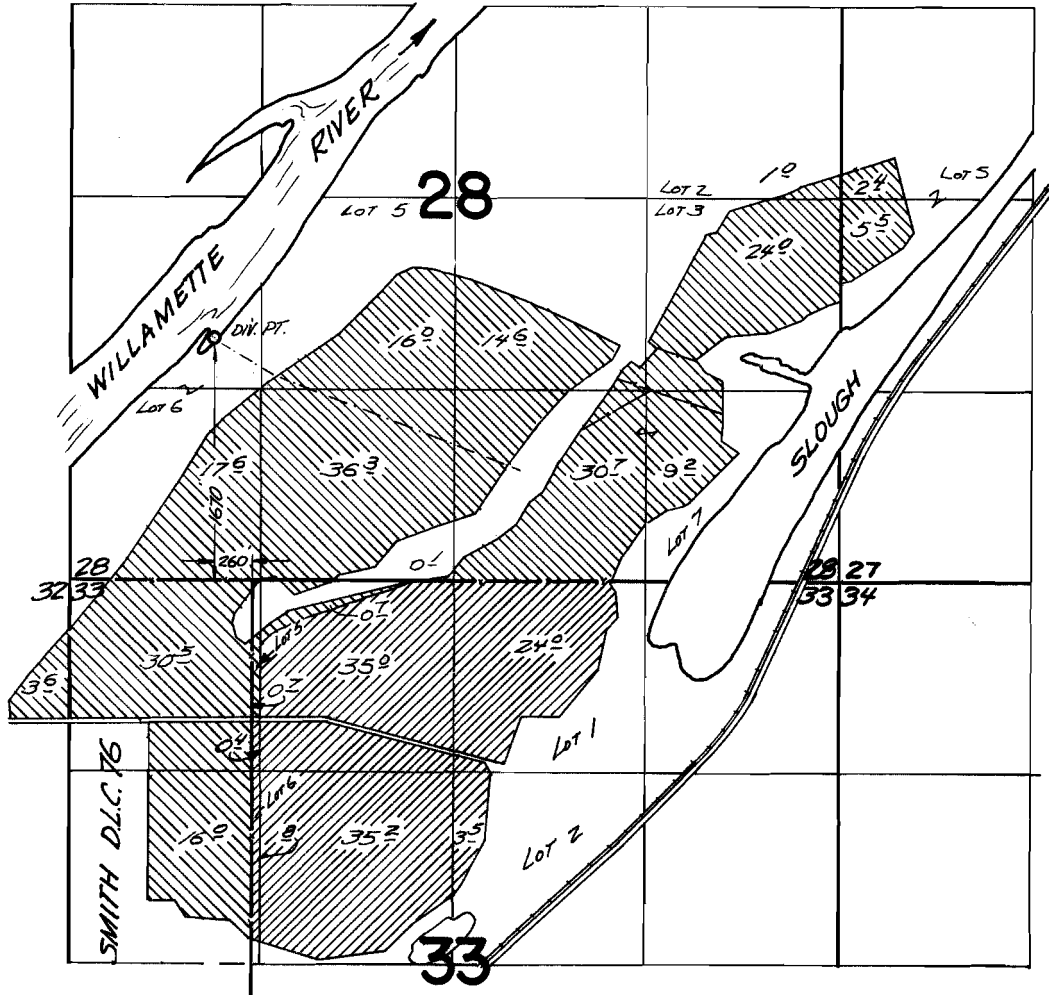



T.7 S. R.3W. W.M.

 

FINAL PROOF SURVEY UNDER

Primary 
Suppl. 

Application No. 43731... Permit No. 32148.
IN NAME OF

THEODORE, ARNOLD and TURFIELD SCHINDLER

Surveyed Oct. 17, 1968, by V. Garner.....