


T. 4S. R. 9 & 10 W. W.M.

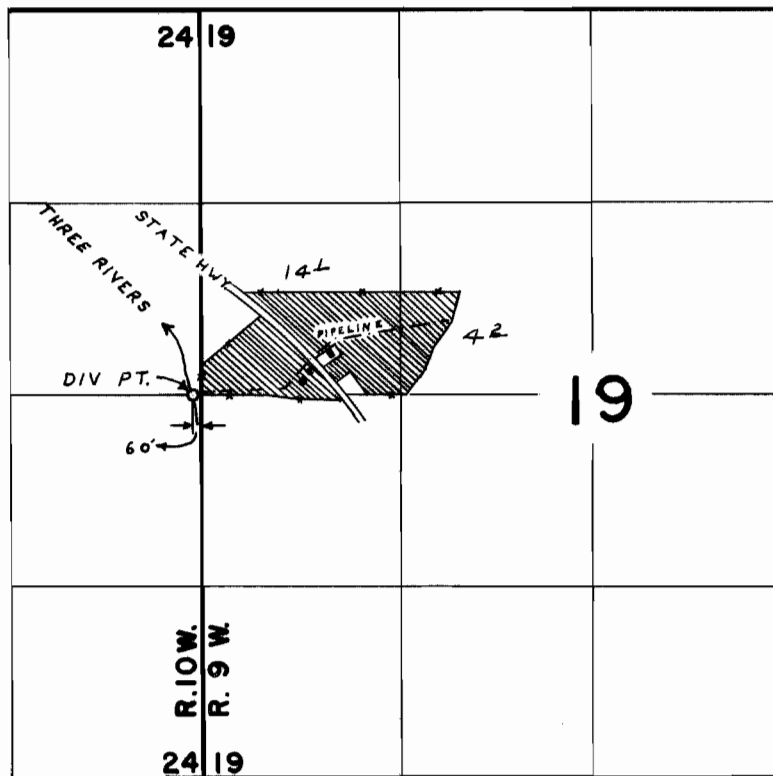

FINAL PROOF SURVEY UNDER

Application No. 33953 Permit No. 26766
IN NAME OF

ELRY W. STEPHENS

Surveyed OCT. 3, 1968, by L. E. GOULD