


T.5S.R.II W.W.M.

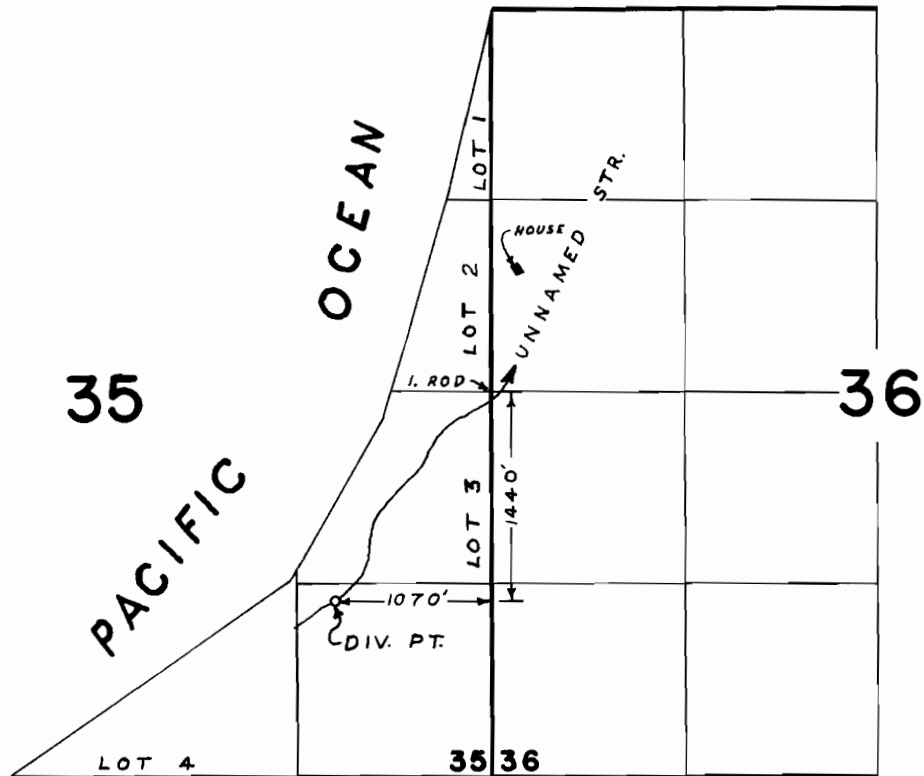

FINAL PROOF SURVEY
UNDER

Application No. **37536** Permit No. **27914**
IN NAME OF

L-E-W ENGINEERING INC.

Surveyed **OCT. 1** 19**68**, by **L. E. GOULD**