


T.4N.R.28E.W.M.

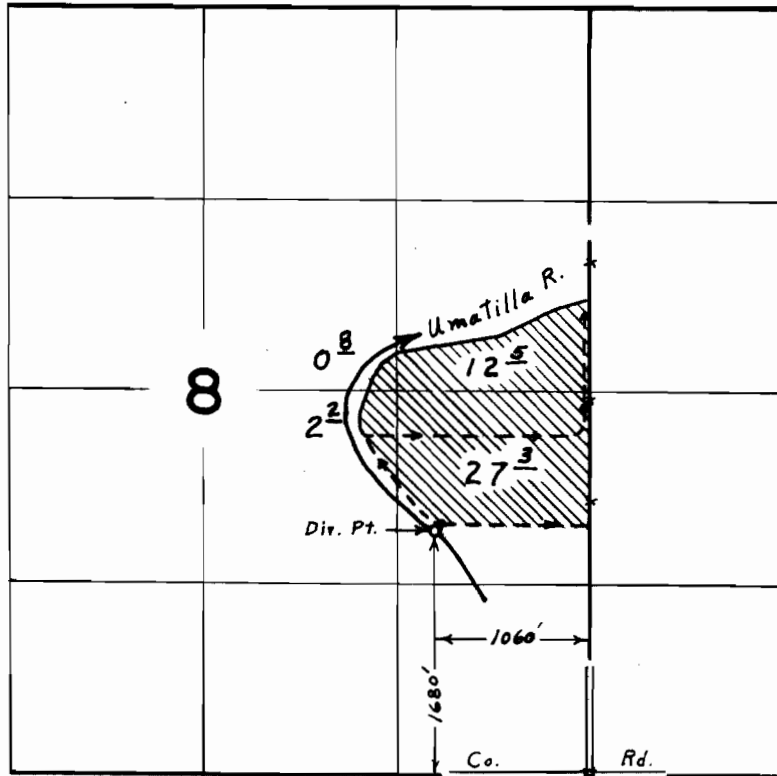

**FINAL PROOF SURVEY**  
UNDER

Application No. 40339 Permit No. 29960  
IN NAME OF

**DONALD SHOCKMAN**

Surveyed June 26 1967, by L. E. Gould