


T.1S. R.38 & 39E.W.M.

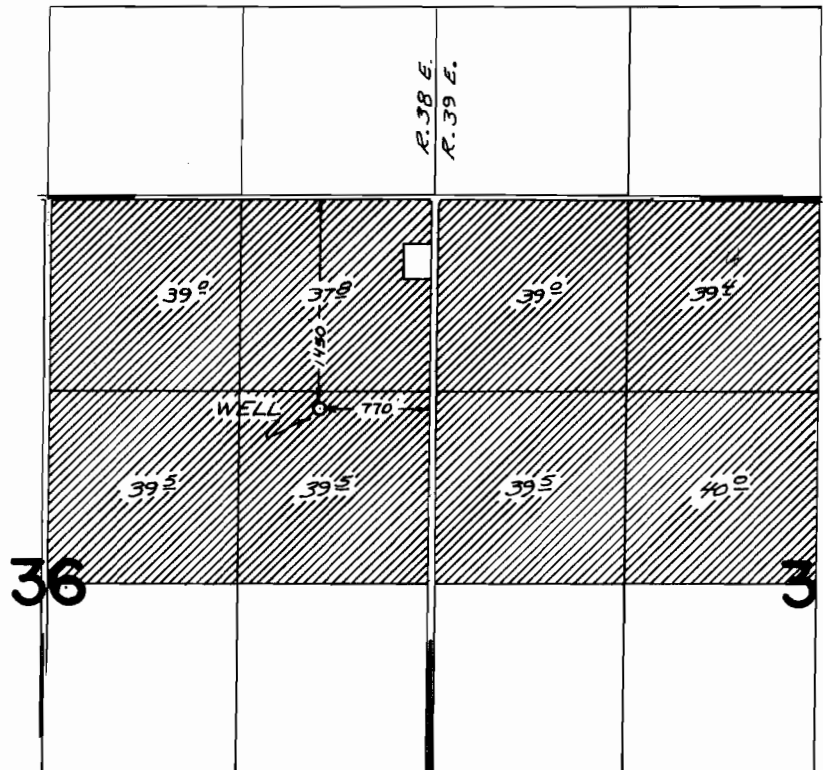

FINAL PROOF SURVEY UNDER

Application No. G-3187 Permit No. G-2993
IN NAME OF

N. H. and MARVA WOODSELL

Surveyed Aug 24 1968 by V. Garner