


T. 2 S. R. 38 E. W. M.

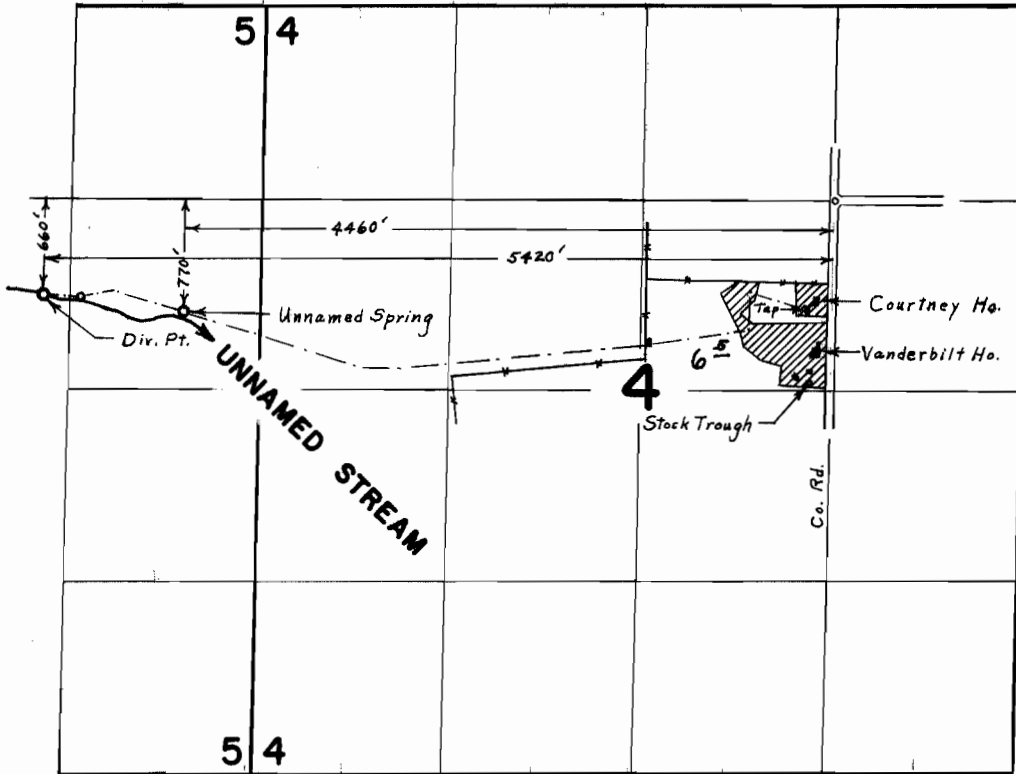

FINAL PROOF SURVEY
UNDER

Application No. 37021 Permit No. 27646
IN NAME OF
JOHN W. VANDERBILT, M. D.
& VERNON J. COURTNEY

Surveyed Aug. 26, 1968, by L. E. Gould