


T. 4 S. R. 39 E. W. M.

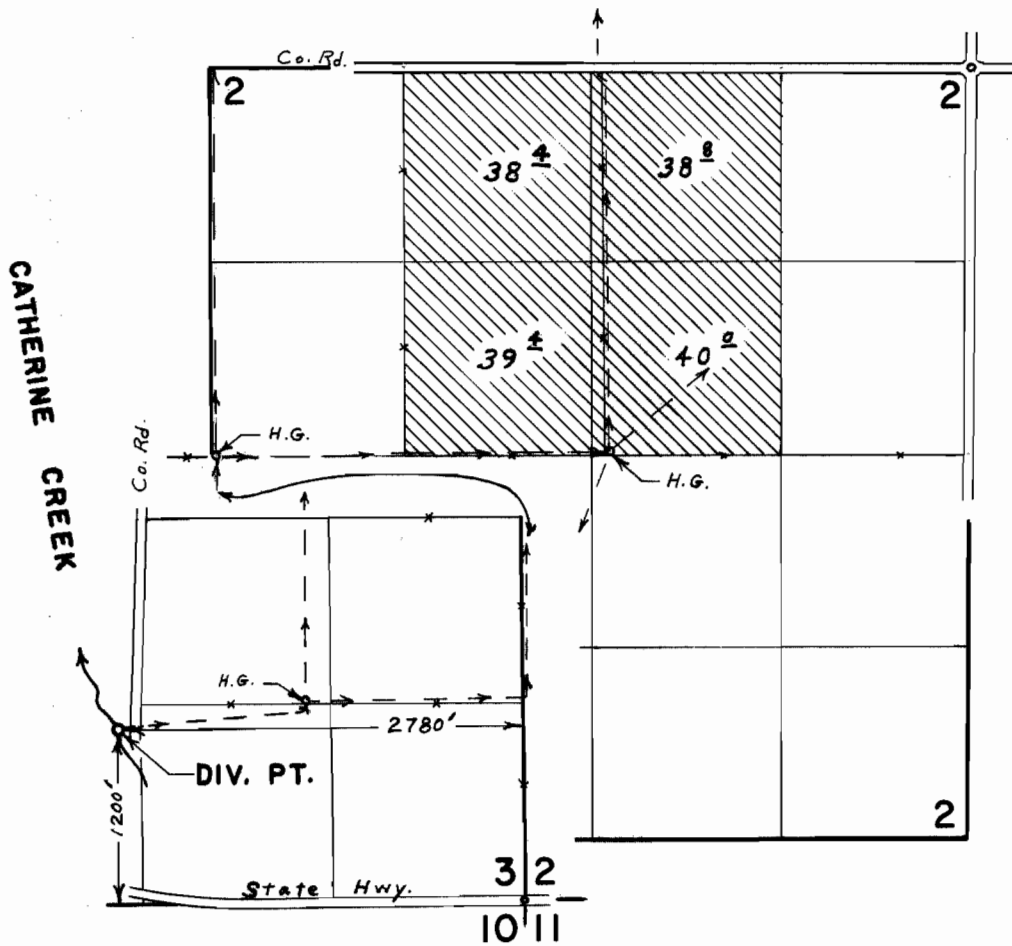

FINAL PROOF SURVEY UNDER

Application No. 38252 Permit No. 28565
IN NAME OF

W. H. & PEARL W. WOODRUFF

Surveyed Aug. 29, 1968, by L. E. Gould