


T. 2 S. R. 39 E. W. M.

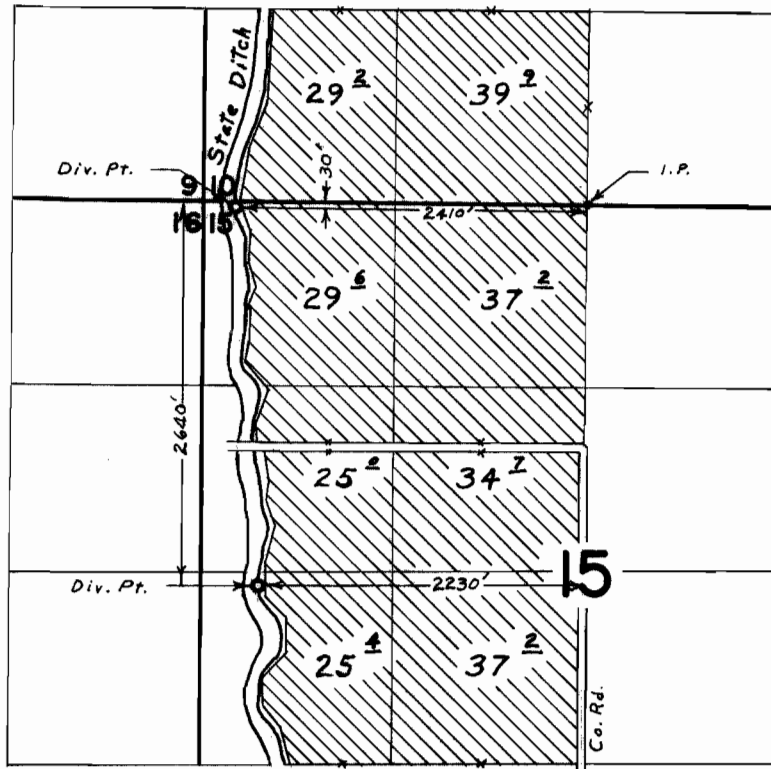

FINAL PROOF SURVEY
UNDER

Application No. 38559 Permit No. 28727

IN NAME OF
JOAN DUCKETT,
ADMINISTRATRIX OF THE BOUVEE ESTATE

Surveyed Aug. 23, 1968, by L. E. Gould