
T. 2 S. R. 3 9 E. W. M.

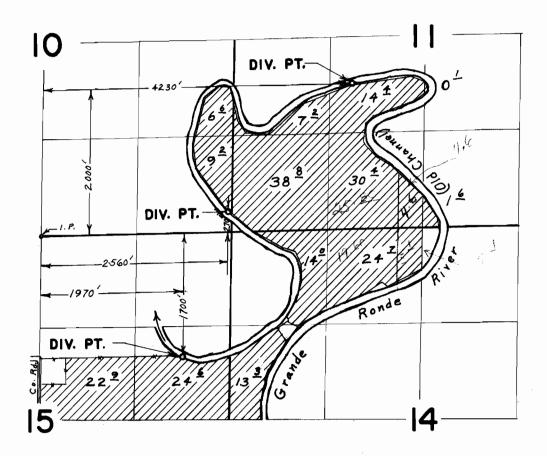

FINAL PROOF SURVEY

Application No. 38560 Permit No. 28728
IN NAME OF
ROY WELLS

Surveyed ...Aug. 23,19...... by E... Gould