


T. 3 S. R. 38 E. W.M.

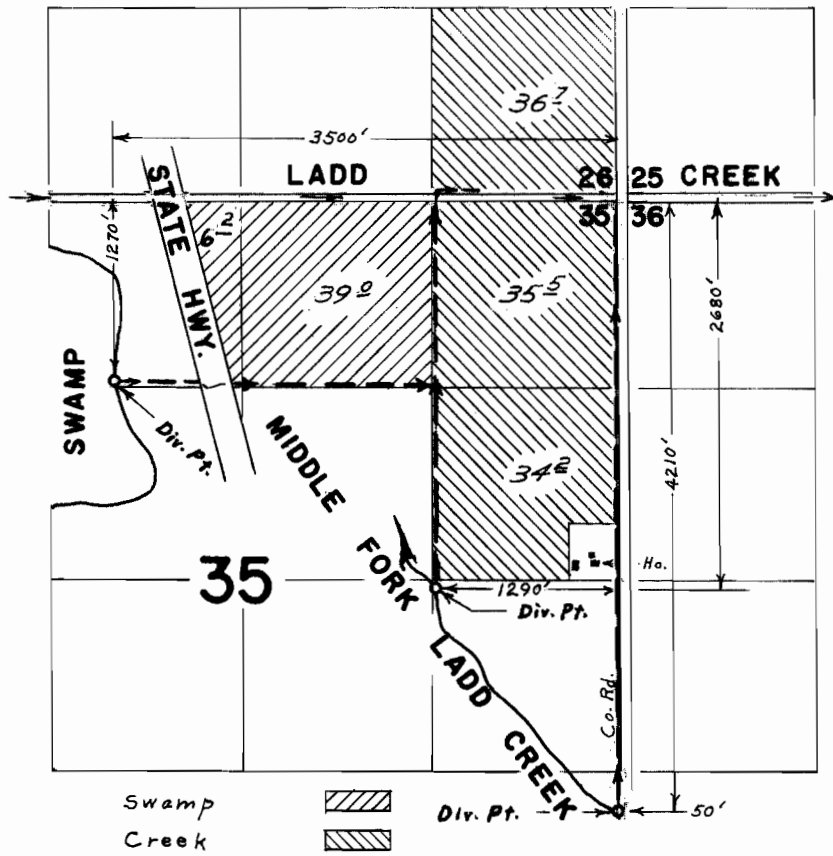

FINAL PROOF SURVEY UNDER

Application No. 38692. Permit No. 28793...
IN NAME OF
CLINTON W. HILL

Surveyed Aug. 21, 1968, by L. E. Gould