


T. 3 S. R. 39 & 40 E. W.M.

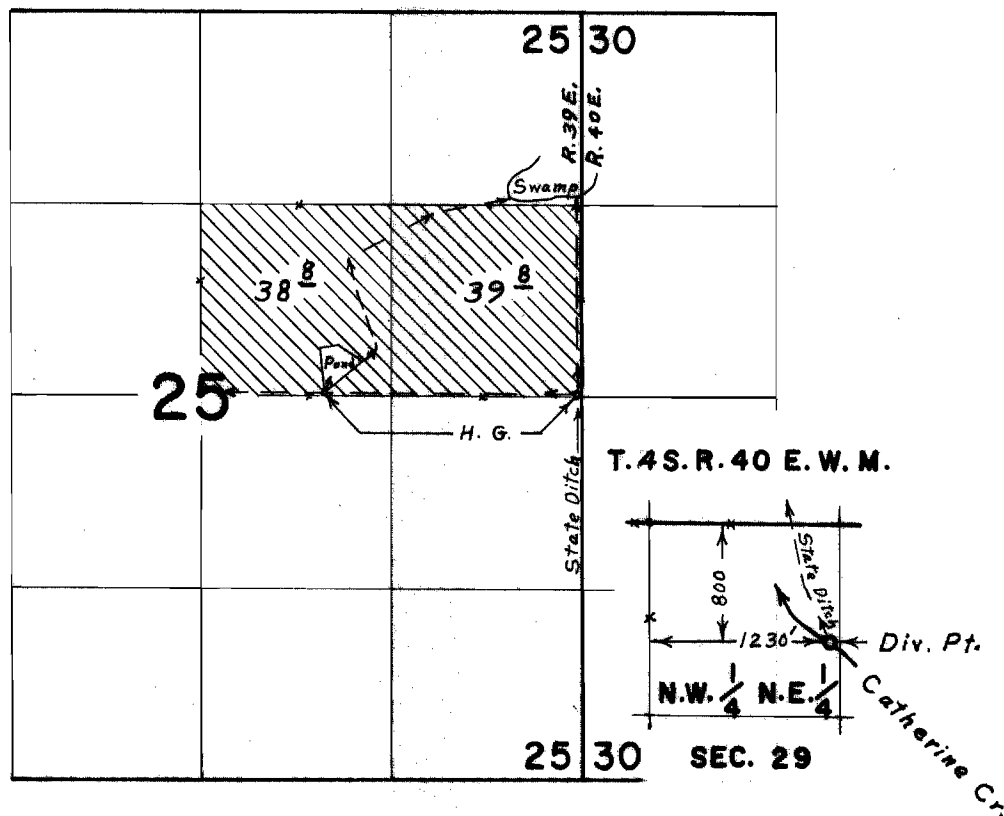

FINAL PROOF SURVEY
UNDER

Application No. 36802 Permit No. 28794
IN NAME OF

CARL G. HELM, Jr.

Surveyed Aug. 26, 1968, by L. E. Gould