


T. 2 & 3 S. R. 4 O E. W. M.

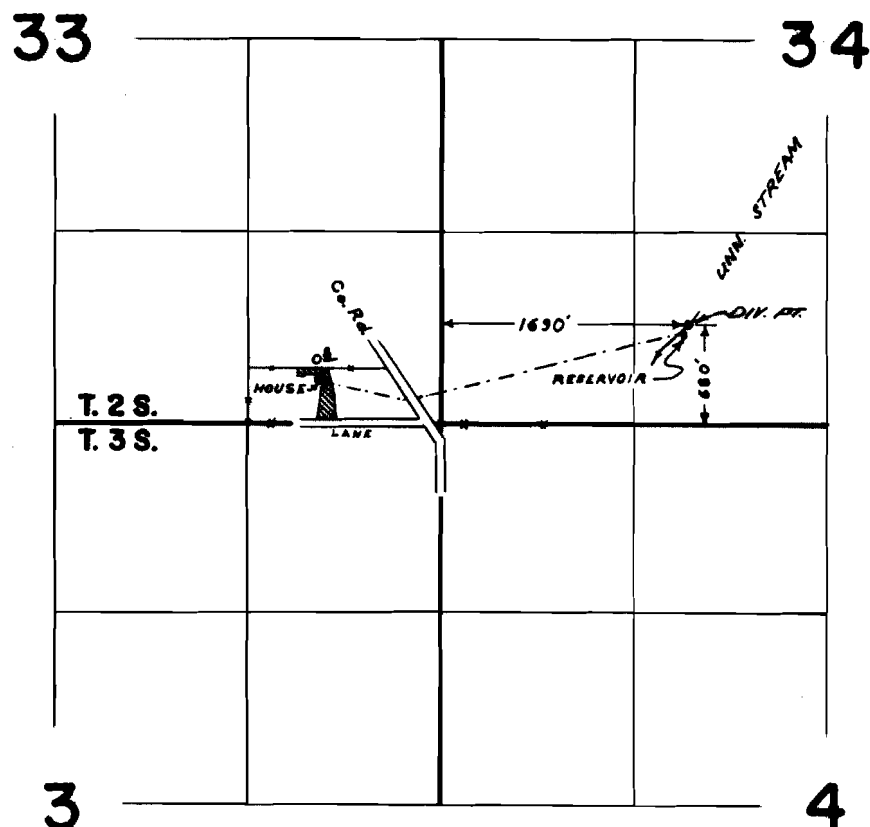

FINAL PROOF SURVEY
UNDER

Application No. 41844 Permit No. 31313

IN NAME OF

CLIFFORD RAGLAND HALL &

VIVIAN ANITA HALL

Surveyed AUG. 24, 1968, by L. E. GOULD