


T.3S. R.3W. W.M.

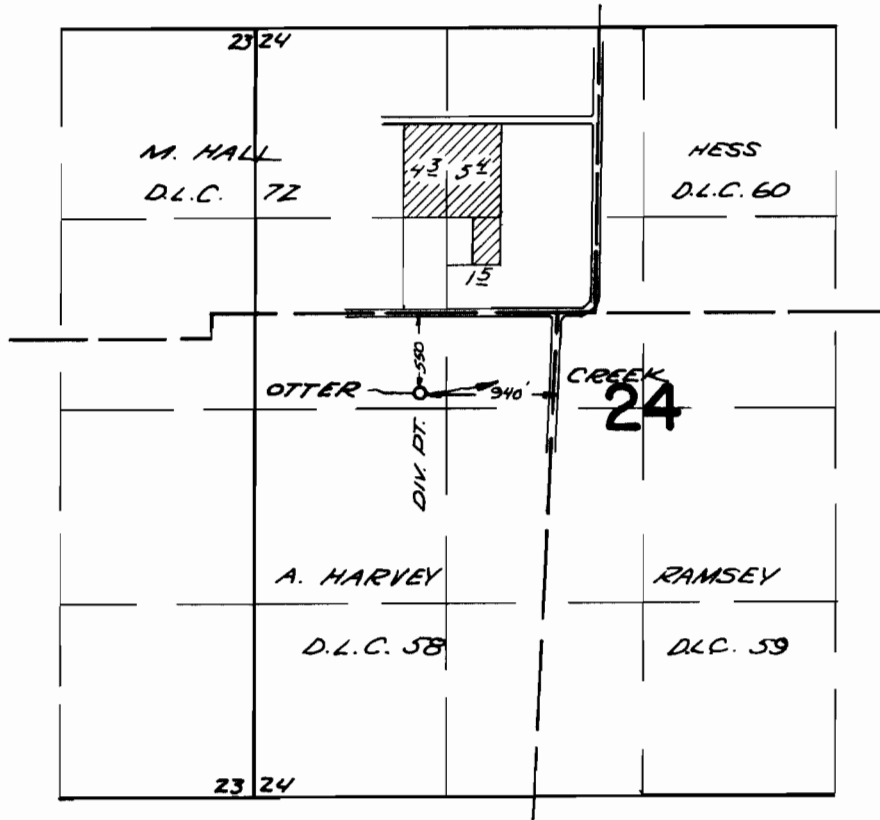

FINAL PROOF SURVEY UNDER

Application No. 38950... Permit No. 28909...
IN NAME OF

ELMER and EILEEN ERBE

Surveyed Oct. 18, 1967, by *V. Garner*.....