


T.4S. R.2E. W.M.

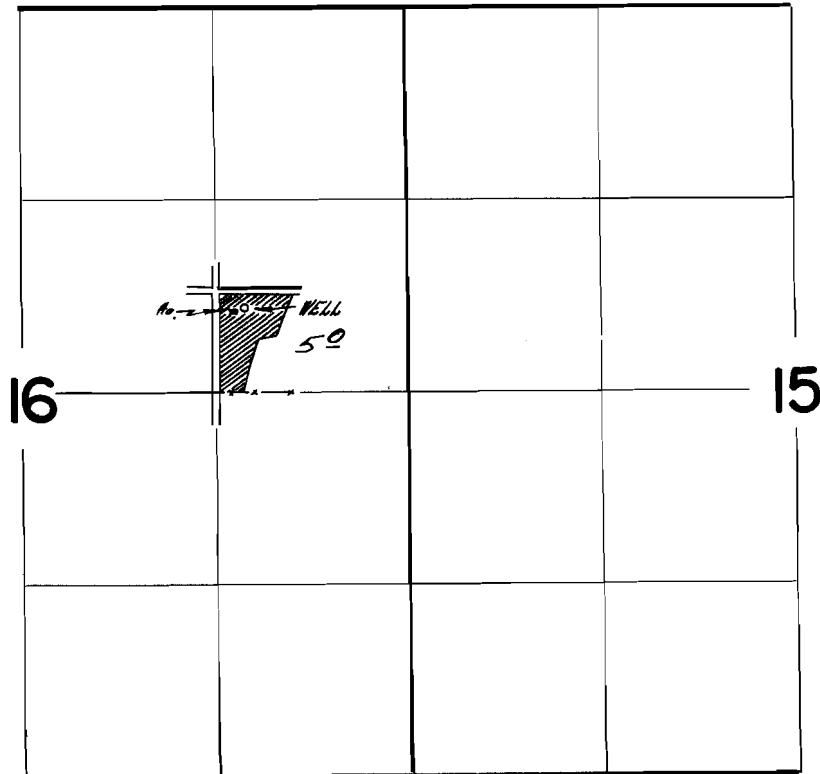

WELL LOCATED 580 FT. N. & 190 FT. E FROM SW CORNER SE $\frac{1}{4}$ NE $\frac{1}{4}$ SECTION 16

FINAL PROOF SURVEY
UNDER

Application No. *G-2237* Permit No. *G-2785*
IN NAME OF

LEONARD A. & CHARLOTTE A. COCHRAN

Surveyed *June 19 1968*, by *W. D. Ruppert*