


T.4S. R.1E. W.M.

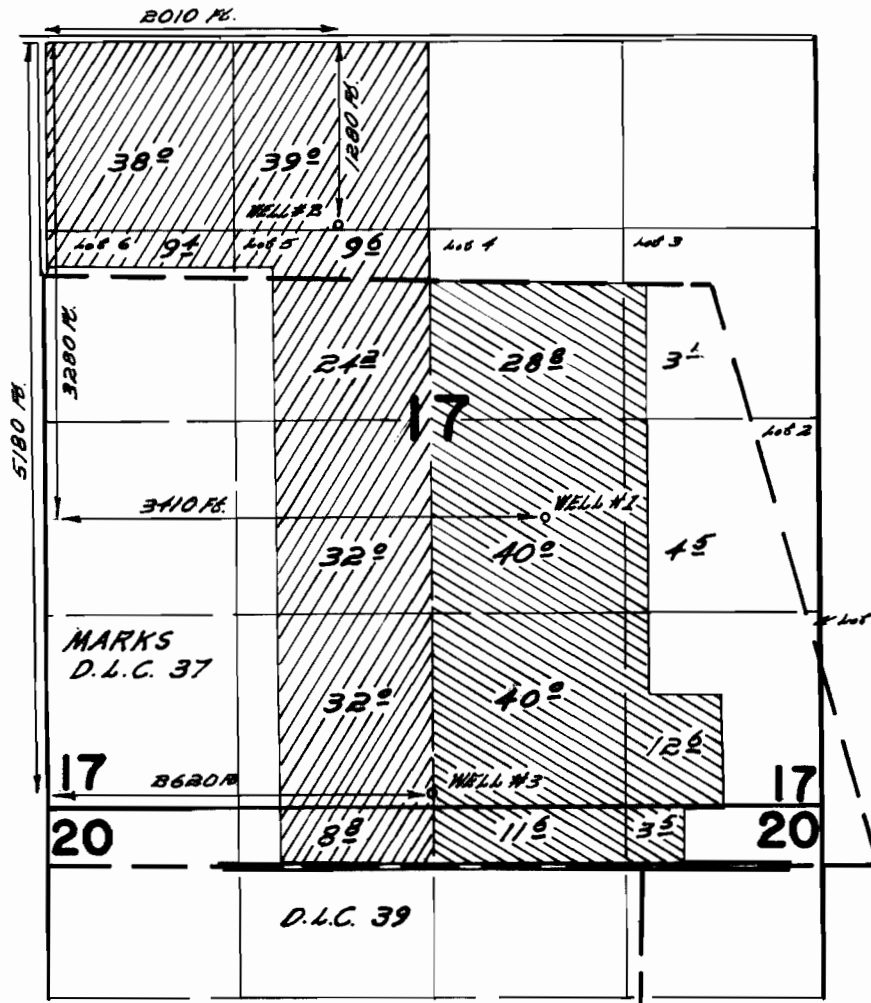

G-2921 PRIMARY WELLS #1,2, & 3
 G-2864 PRIMARY WELL #1
 G-2921 SUPPL. WELLS #2 & 3

FINAL PROOF SURVEY UNDER

G-3077 G-2864
 Application No. G-3223. Permit No. G-2921.
 IN NAME OF

OECO CORPORATION
AGRICULTURAL SCIENCES, INC.
 Surveyed July 3, 1968, by W. O. Ruppert.