


T.5S. R.2E. W.M.

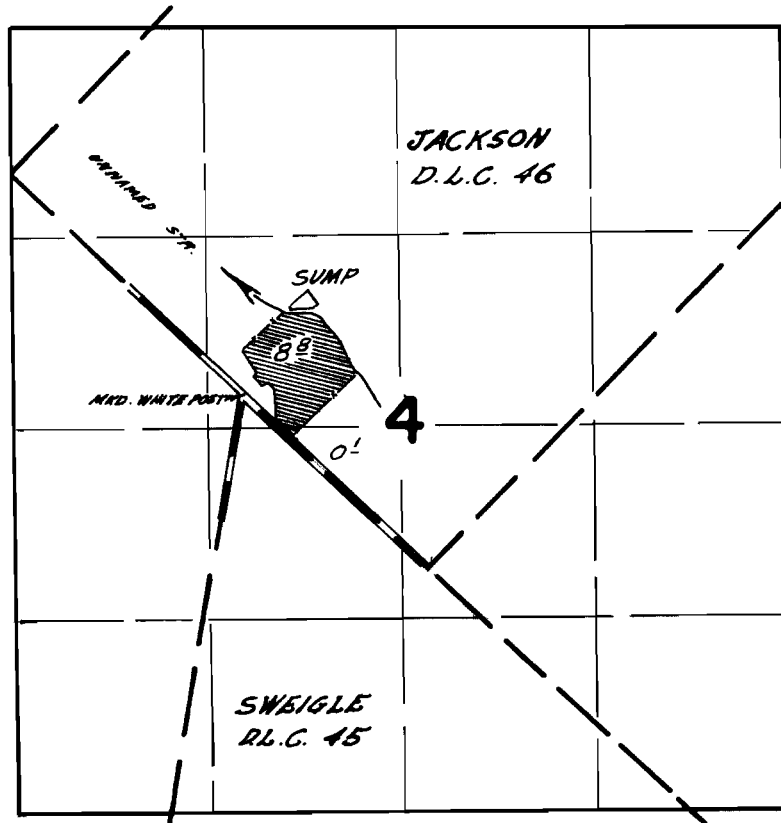

SUMP LOCATED 650 FEET N & 450 FEET E FROM MOST NORTHERLY CORNER SWEIGLE D.L.C. 45

FINAL PROOF SURVEY UNDER

Application No. ~~G-3717~~ Permit No. ~~G-3515~~
IN NAME OF

JOE BRINKMAN

Surveyed July 25 1968, by W.D. Puppert