


T. 4 S. R. 1 E. W. M.

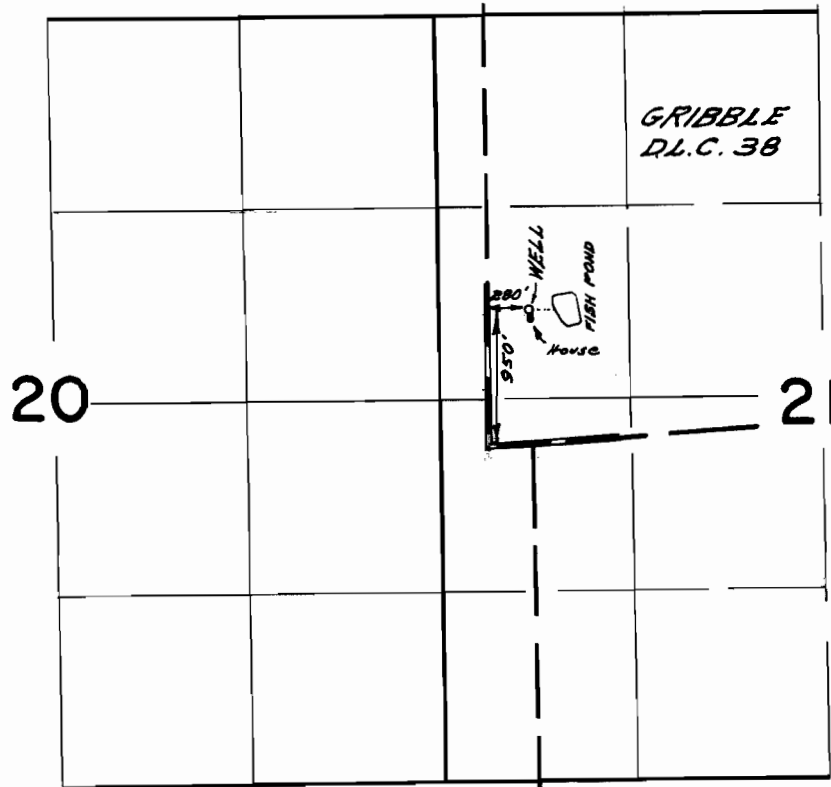

FINAL PROOF SURVEY
UNDER

Application No. *G-3855* Permit No. *G-3634*
IN NAME OF

CLYDE RITTER

Surveyed *July 23, 1968*, by *H. W. Pappert*