


T.4S. R.1E. W.M.

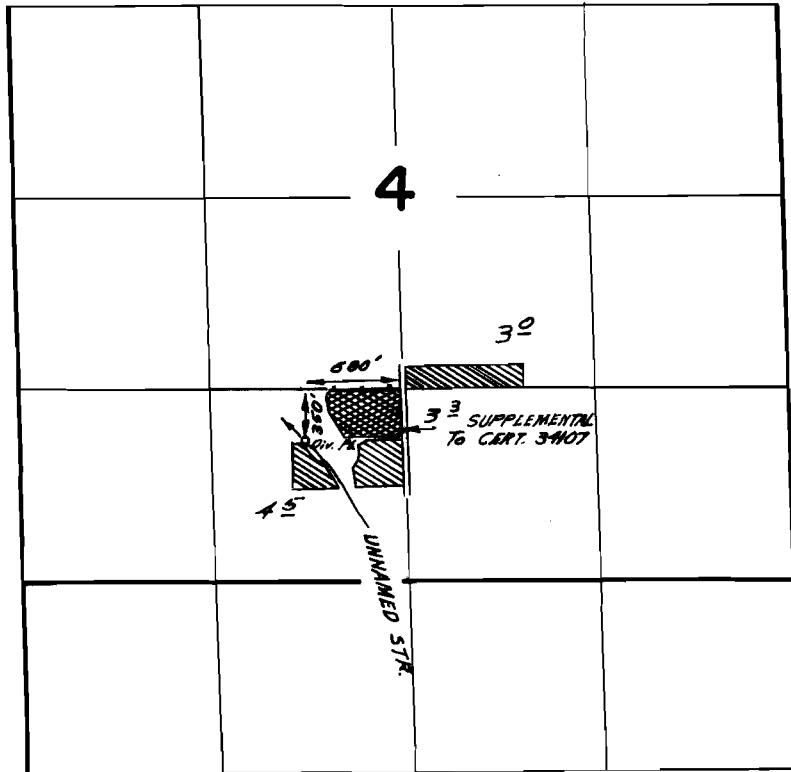

FINAL PROOF SURVEY UNDER

Application No. ~~10747~~ Permit No. 30527
IN NAME OF

JOHN W. BECK

Surveyed June 20 1968, by *W. J. Ruppert*