


T.4S. R.2E.W.M.

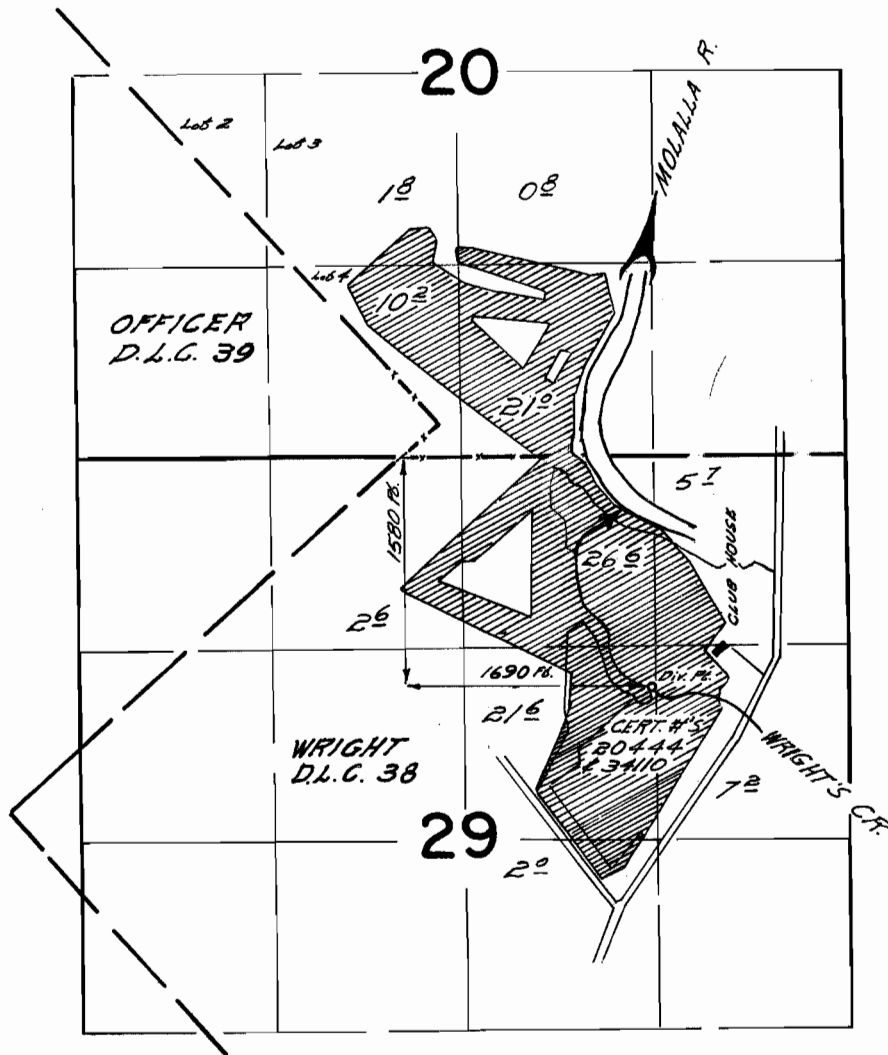

FINAL PROOF SURVEY UNDER

Application No. 42268 Permit No. 31117
IN NAME OF

GILBERT O. KAPPLER

Surveyed July 24 1968, by Wd. Ruppert