


T. 28 S. R. 14 W. W.M.

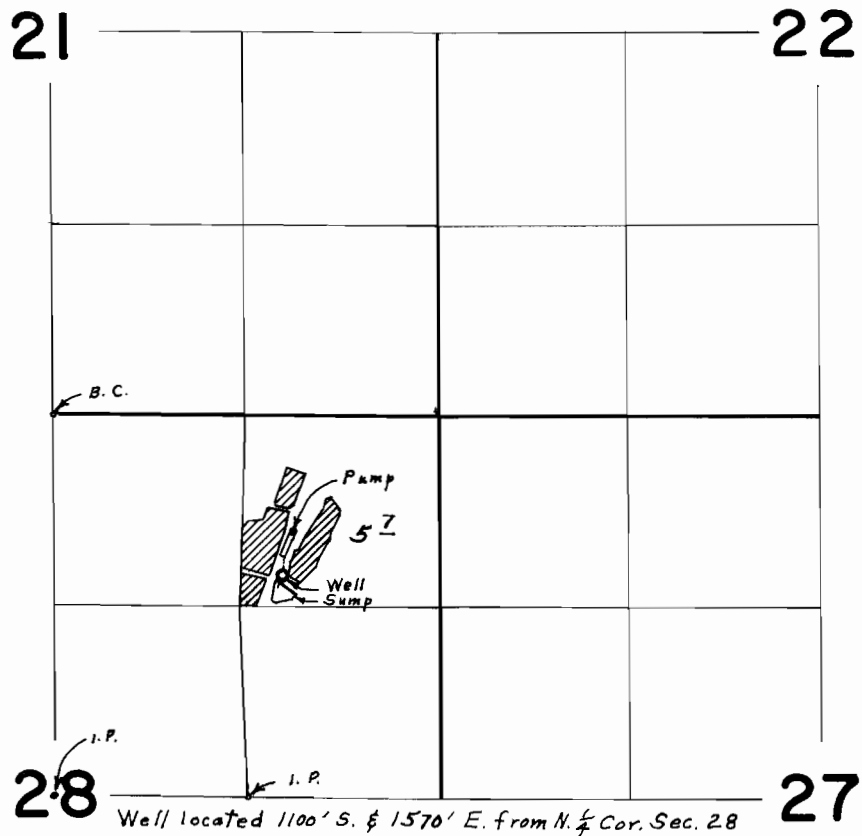

FINAL PROOF SURVEY
UNDER

Application No. G-3652 Permit No. G-3431
IN NAME OF

R. W. STRONG

Surveyed July 17, 1968, by L. E. Gould