


T. 28 S. R. 14 W. W. M.

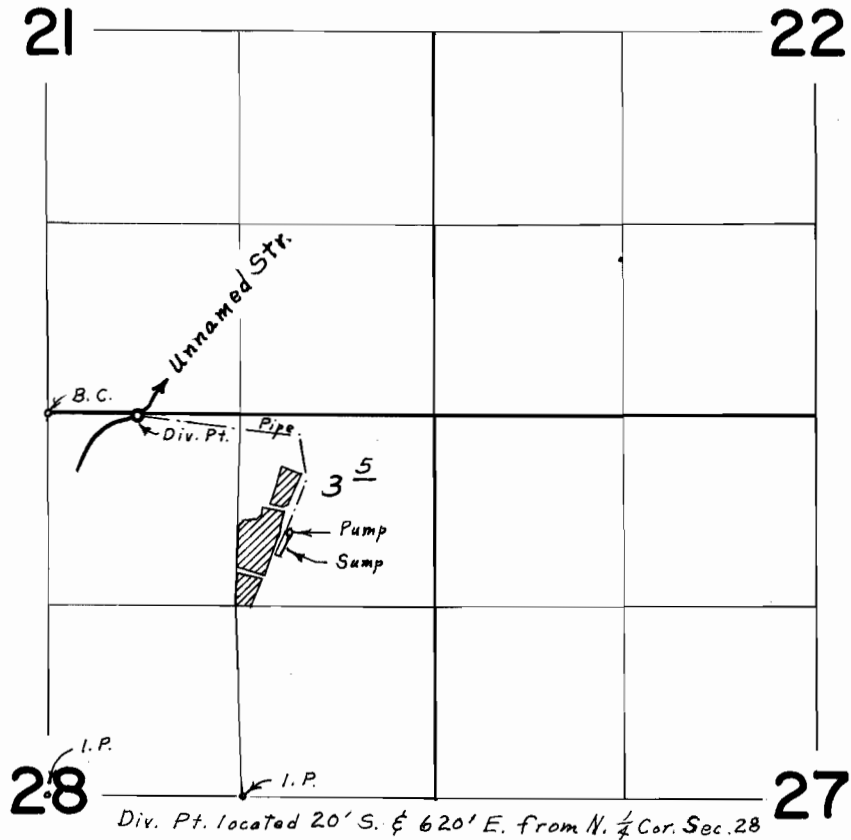

FINAL PROOF SURVEY UNDER

Application No. 36965 Permit No. 27556
IN NAME OF

R. W. STRONG

Surveyed July 17, 1968, by L. E. Gould