


T.34S.R.11W.W.M.

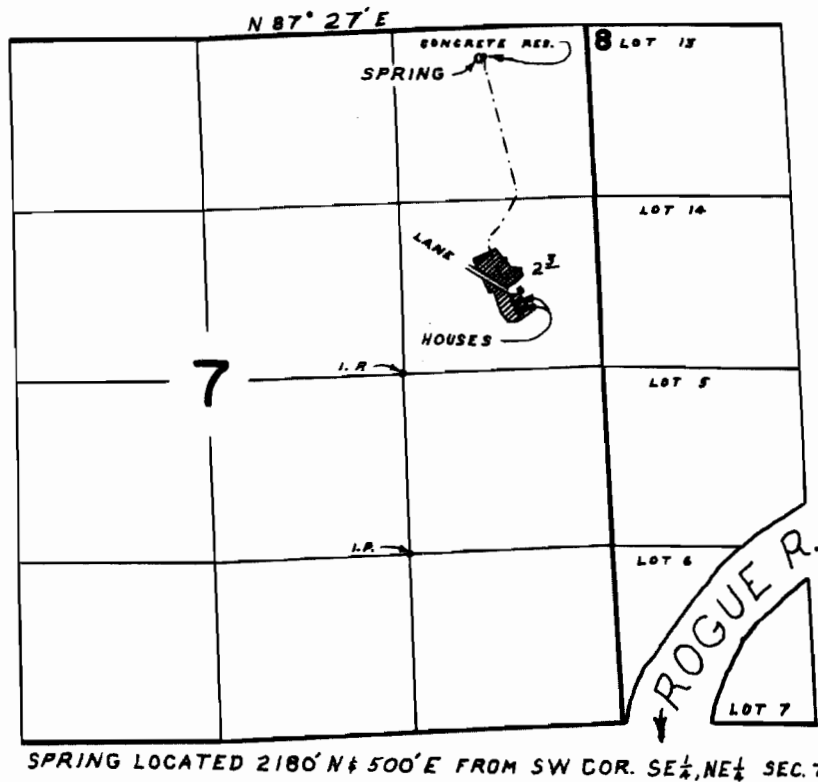

FINAL PROOF SURVEY
UNDER

Application No. **34565** Permit No. **27147**
IN NAME OF

ROBERT M. and MILDRED A. COOK

Surveyed **SEPT. 12 1968**, by **L. E. GOULD**