


T.34S.R.II.W.W.M.

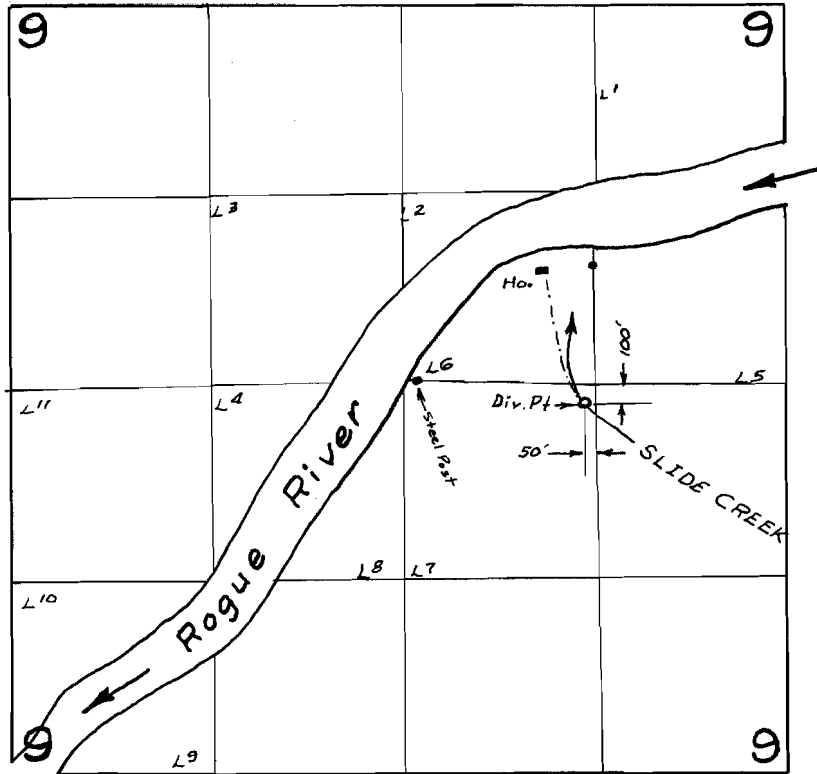

FINAL PROOF SURVEY
UNDER

Application No. 40154 Permit No. 29933
IN NAME OF

THOS. G. STALEY

Surveyed SEPT. 10 1968, by L. E. GOULD