


T.32S. R.5W. W.M.

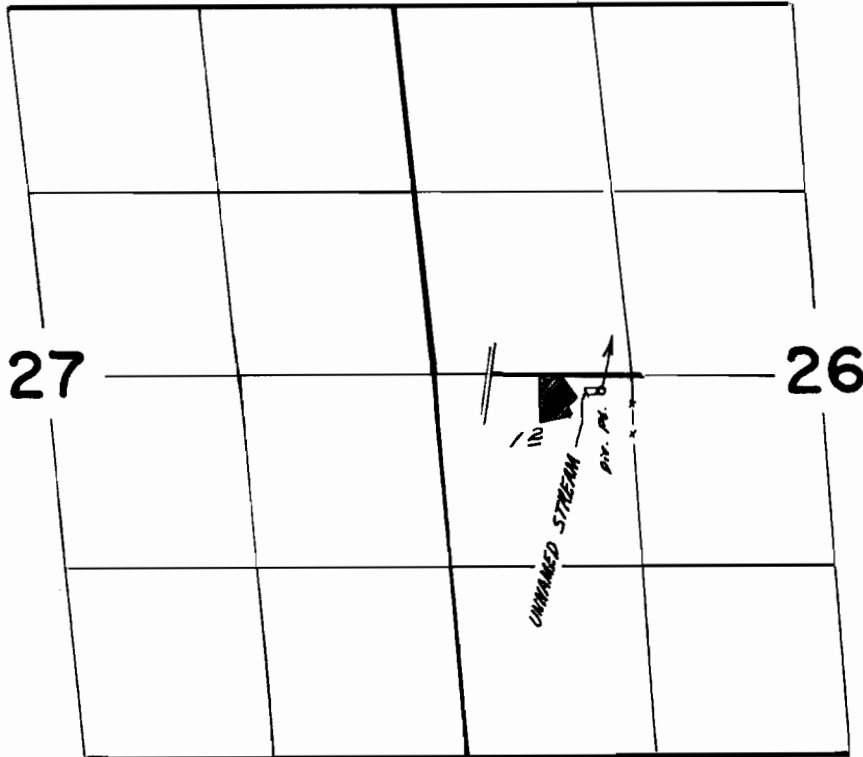

*Diversion point located 100 ft. S. & 220 ft. N. from NE. corner
NW 1/4 SW 1/4 Section 26*

FINAL PROOF SURVEY
UNDER

Application No. 10255 Permit No. 30013
IN NAME OF

MRS. MARY S. O'BRIEN

Surveyed May 2, 1968, by L. E. Gould
June 27, 1969