


T. 30 S. R. 3 W. W. M.

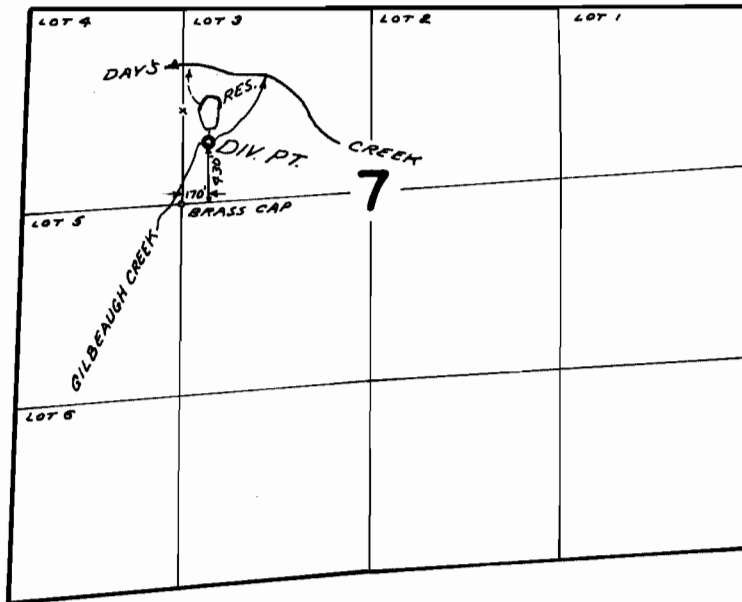

FINAL PROOF SURVEY

UNDER

Application No. R-40495
40520 Permit No. R-4522
30181
IN NAME OF

DELBERT B. BLANCHARD

Surveyed APR. 17, 1968, by V. GARNER