


T. 30S. R. 3W. W.M.

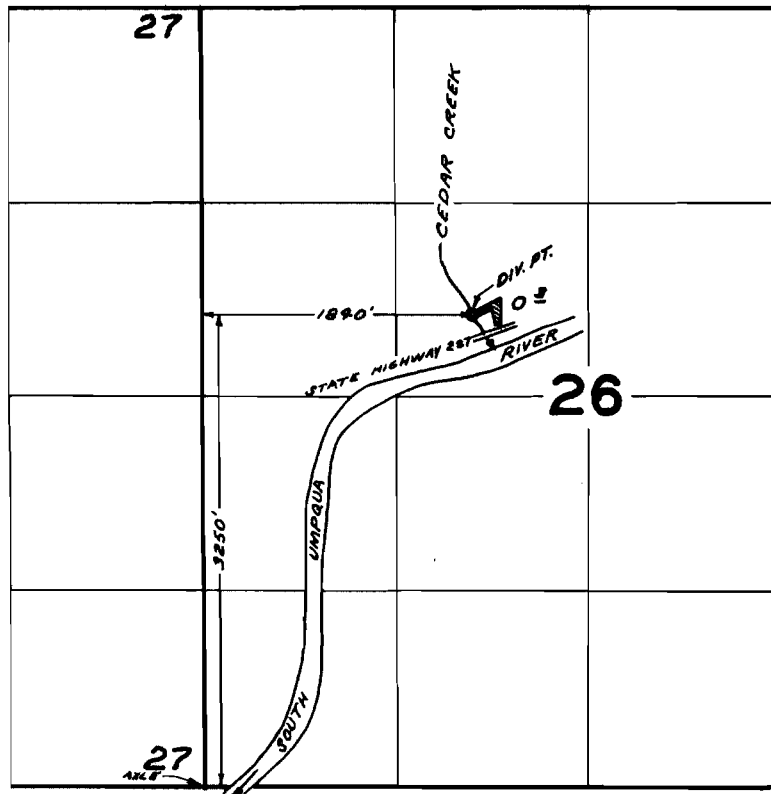

FINAL PROOF SURVEY
UNDER

Application No. 40886 Permit No. 30475

IN NAME OF
ROBERT T. JUNE
BY **JIM L. JENKS**

Surveyed APR. 18 1968, by V. GARNER