


T. 31S. R. 1W. W.M.

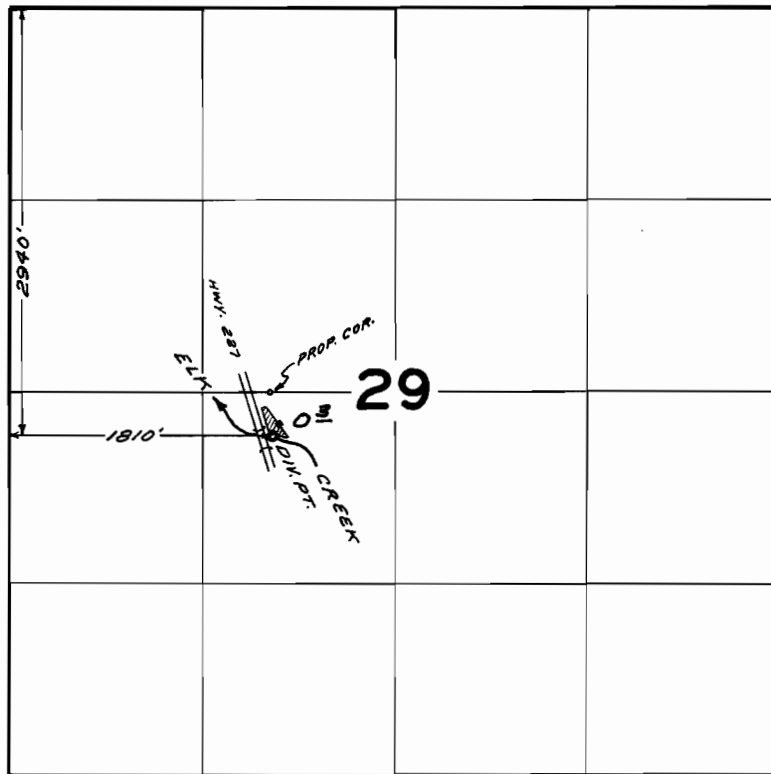

FINAL PROOF SURVEY
UNDER

Application No. 41080 Permit No. 30645
IN NAME OF

ARNOLD R. TINKER

Surveyed APR. 16 1968, by V. GARNER