


T.22S.R.5W.W.M.

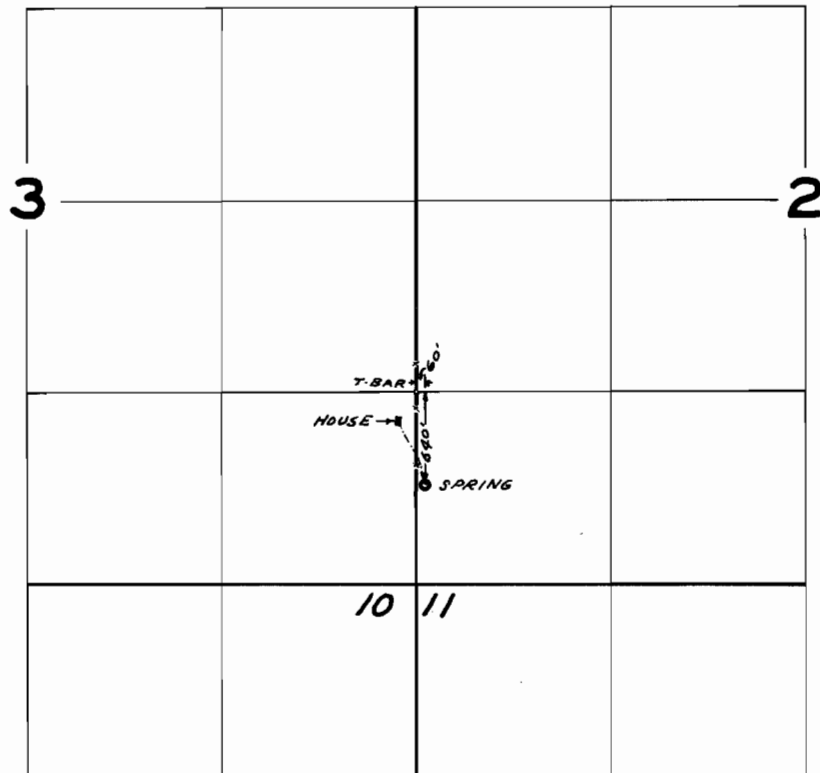

FINAL PROOF SURVEY
UNDER

Application No. 42342 Permit No. 31682
IN NAME OF

WALLACE N. AND VIRGINIA W. BEAN

Surveyed APR. 30 1968, by V. GARNER