


T.26S.R.6W.W.M.

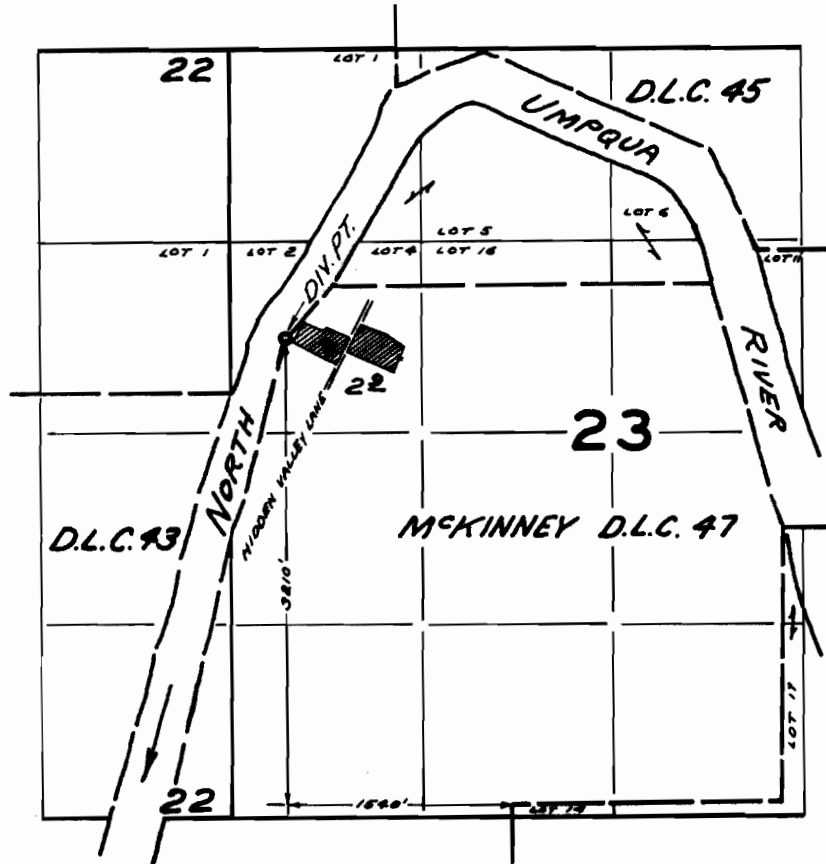

FINAL PROOF SURVEY
UNDER

Application No. 43419 Permit No. 32462

IN NAME OF
TROWBRIDGE R. MAFIT, MD
BEVERLY M. MAFIT

Surveyed OCT. 1 1968, by V. GARNER