


T.9S. R.27E.W.M.

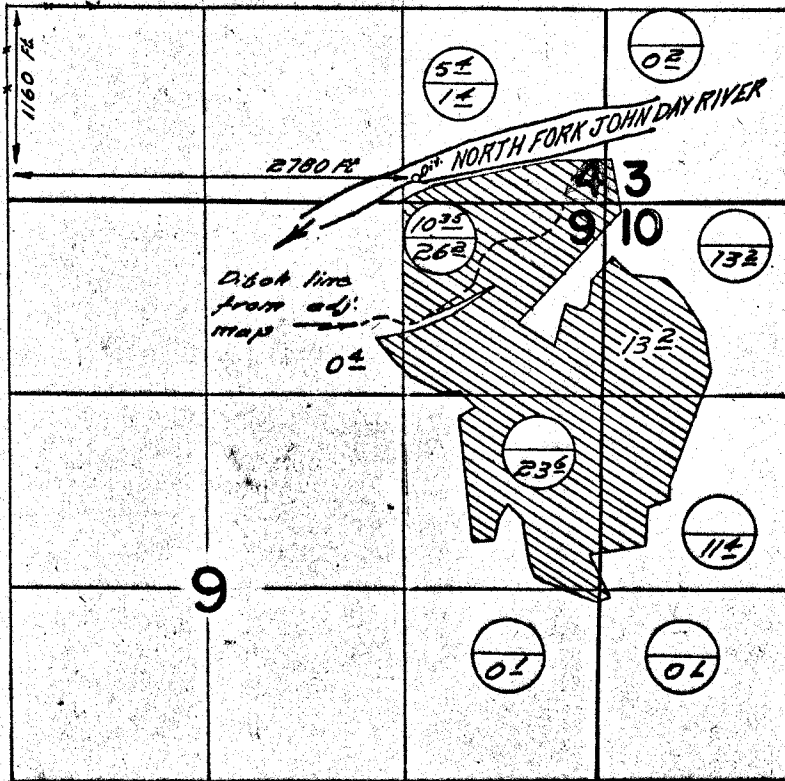

⊖ PRIOR RIGHTS
PERMIT 2716

FINAL PROOF SURVEY UNDER

Application No. 34531 Permit No. 27116...
IN NAME OF

DAN W. CHAMNESS &
JACK B. LIVELY
Surveyed May 15 1968, by W. J. Ruppert