


T.37S.R.1W.W.M.

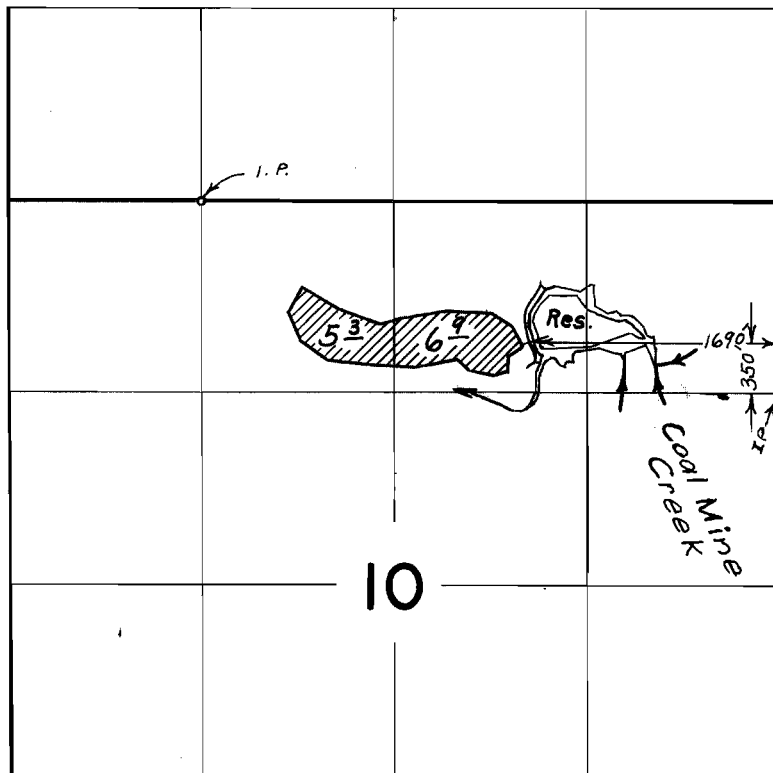

**FINAL PROOF SURVEY**  
UNDER

Application No. R-29362 Permit No. R-1683  
IN NAME OF  
**FRED W. NELSON**

Surveyed July 26, 1967, by L.E. Gould