


T. 34 S.R. 1 W.W.M.

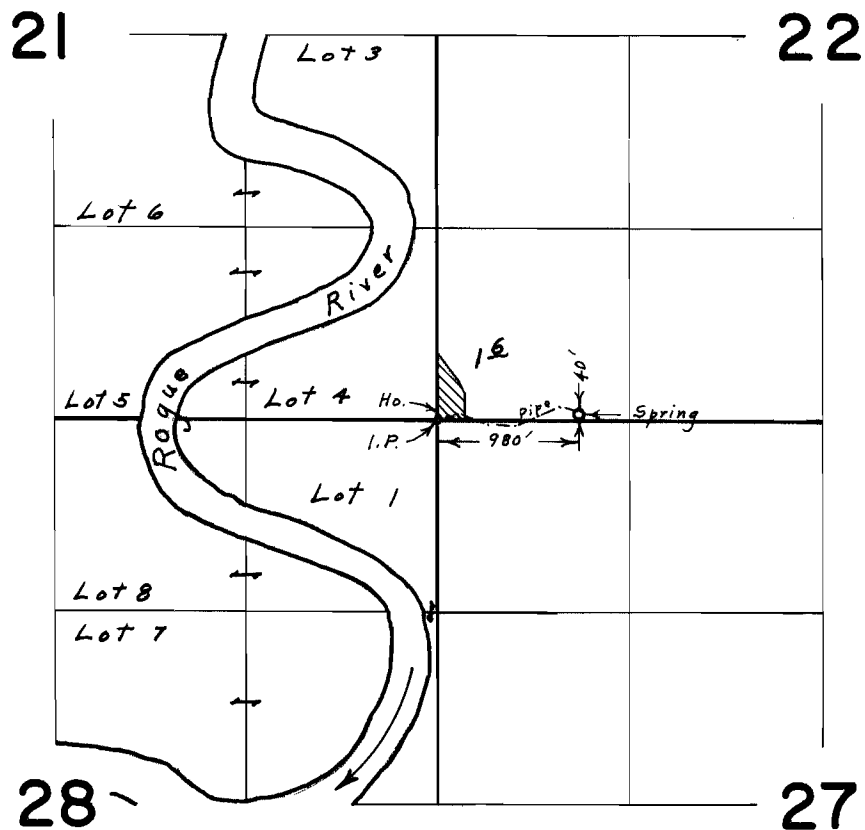

FINAL PROOF SURVEY UNDER

Application No. 39599 Permit No. 29429
IN NAME OF

JOHN K. & PATRICIA A. NIEMELA

Surveyed May 20, 1968, by L. E. Gould