


T.18S.R.5W.W.M.

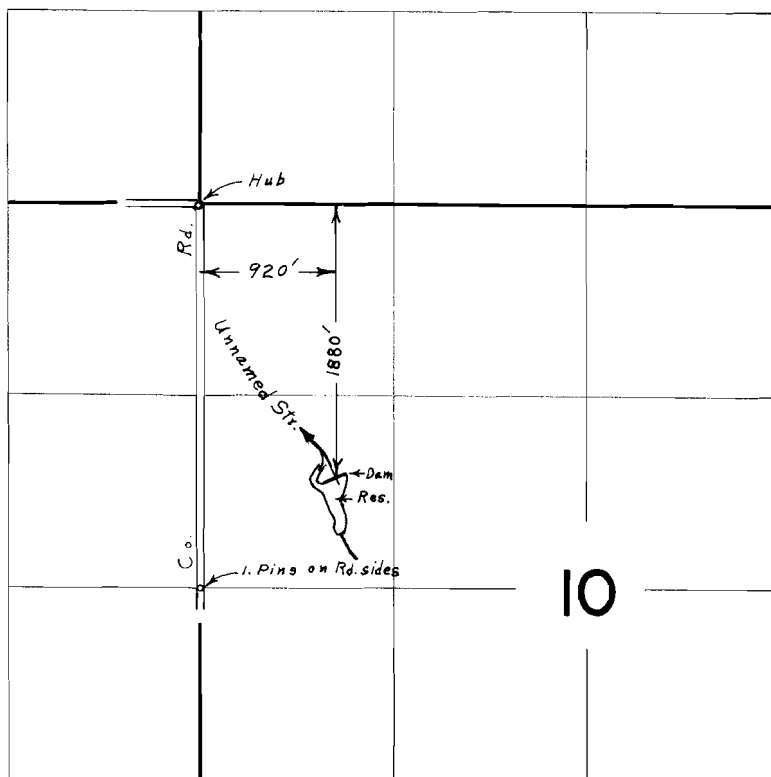

FINAL PROOF SURVEY
UNDER

Application No. R-41038 Permit No. R-4671

IN NAME OF

THOMAS F. DODSON, JR.

Surveyed July 21, 1967, by L. E. Gould