


T.15 S. R.6 W. W.M.

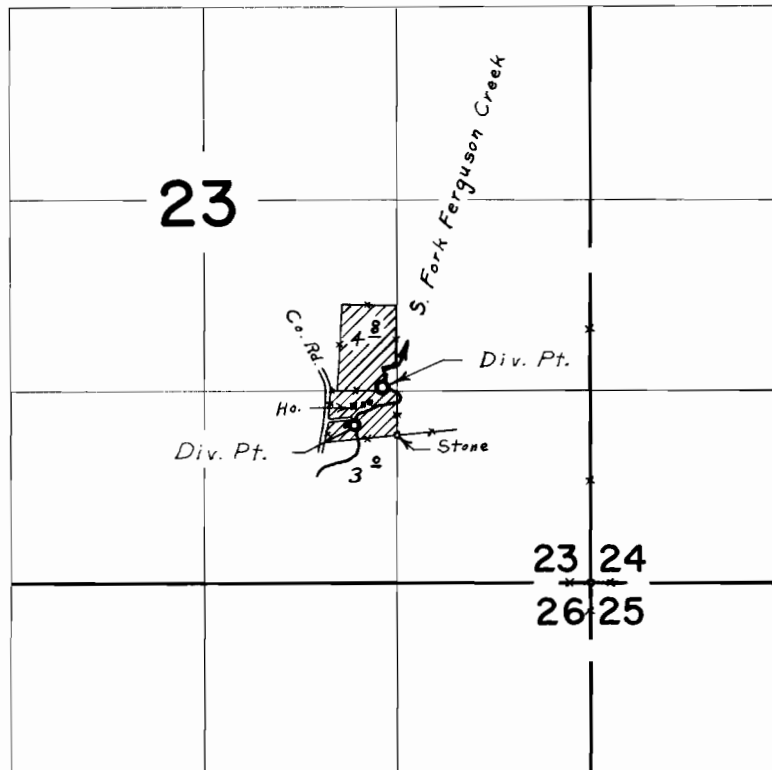

Div. Pts. located; 1340' N. & 1420' W; 1080' N. & 1610' W. both from S. E. Cor. Sec. 23

FINAL PROOF SURVEY
UNDER

Application No. **39404** Permit No. **29368**
IN NAME OF

JOSEPH LE GENDRE

Surveyed **Nov. 15, 1968**, by **W. J. Ruppert**