


T.15&16S.R.6W.W.M.

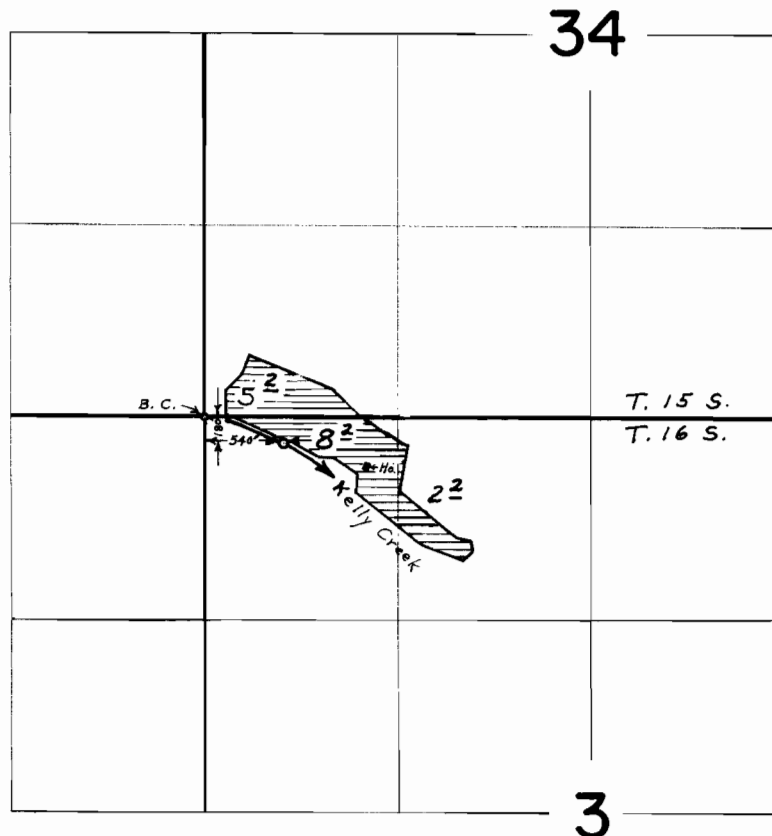

FINAL PROOF SURVEY
UNDER

Application No. 39596 Permit No. 29426
IN NAME OF
GLEN E. WILLIAMS

Surveyed May 2, 1967, by L. E. Gould