


# T. 22 S. R. 1 W. W. M.

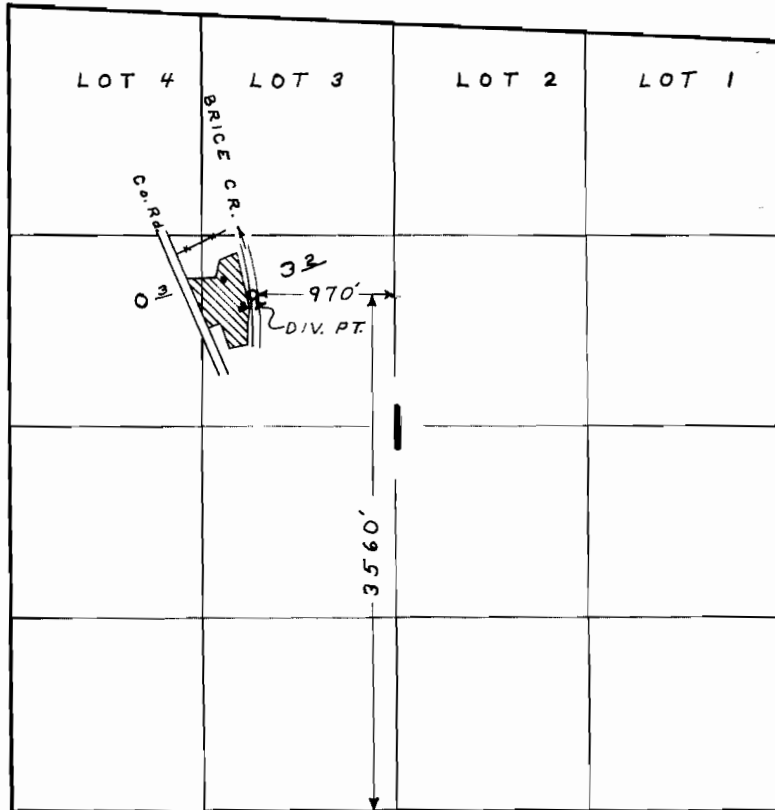

## FINAL PROOF SURVEY UNDER

Application No. **39695** Permit No. **29541**  
IN NAME OF

**LEWIS A. HART**.....

Surveyed **OCT. 10 1968**, by **L. E. GOULD**