


T. 18 S. R. 1 W. W.M.

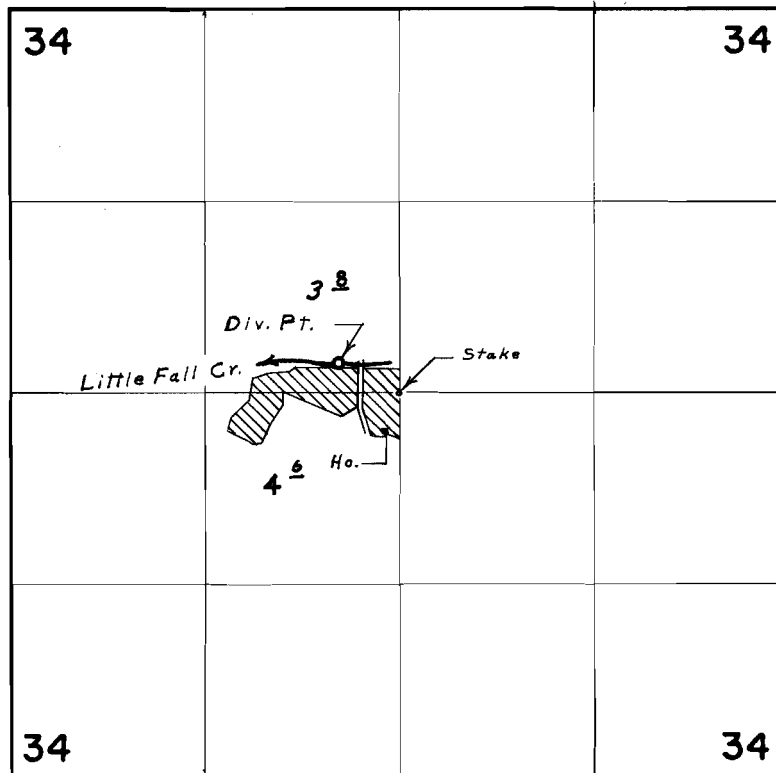

Div. Pt. located 190' N. & 420' W. from center Sec. 34

FINAL PROOF SURVEY
UNDER

Application No. 43425 Permit No. 32466
IN NAME OF

WALTER A. ULLMAN

Surveyed NOV. 7, 1968, by W. J. Ruppert