


T.11&12S. R.4W. W.M.

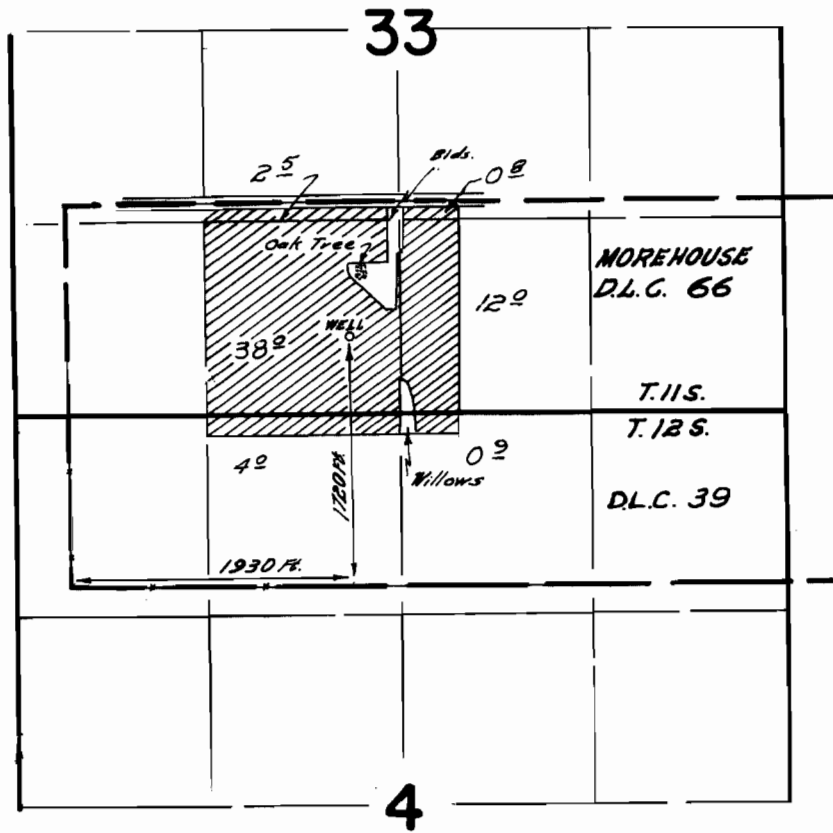

**FINAL PROOF SURVEY**  
UNDER

Application No. *G-2521* Permit No. *G-2336*

IN NAME OF  
**OAK KNOLL FARMS**  
**DALE FISCHER & H.B. SMITH, PARTNERS**

Surveyed June 20 1969, by *H.C. Ruppert*