


# T. I. OS. R. I. W. & I. E. W. M.

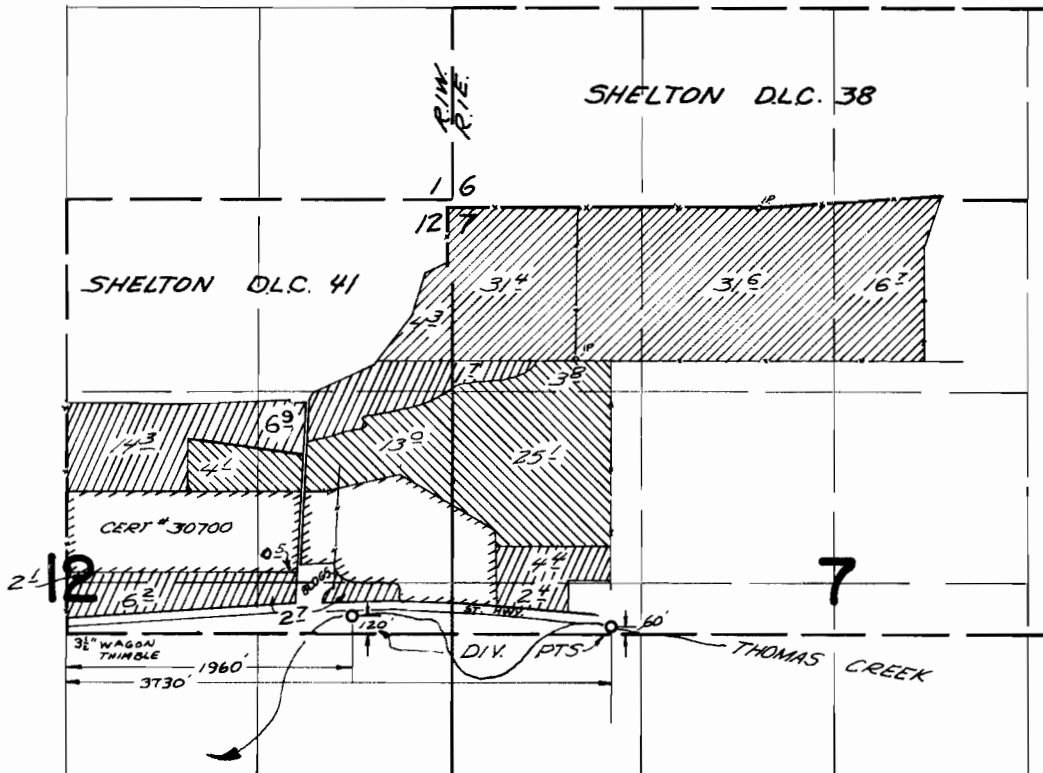

## FINAL PROOF SURVEY UNDER

38483                      28657  
 42066                      31485  
 Application No. 42550      Permit No. 31801

IN NAME OF

*HAFCO INC.*

Surveyed Nov. 6, 1968, by *V. Garner*