



# T. I. OS. R. I. W. & I. E. W. M.

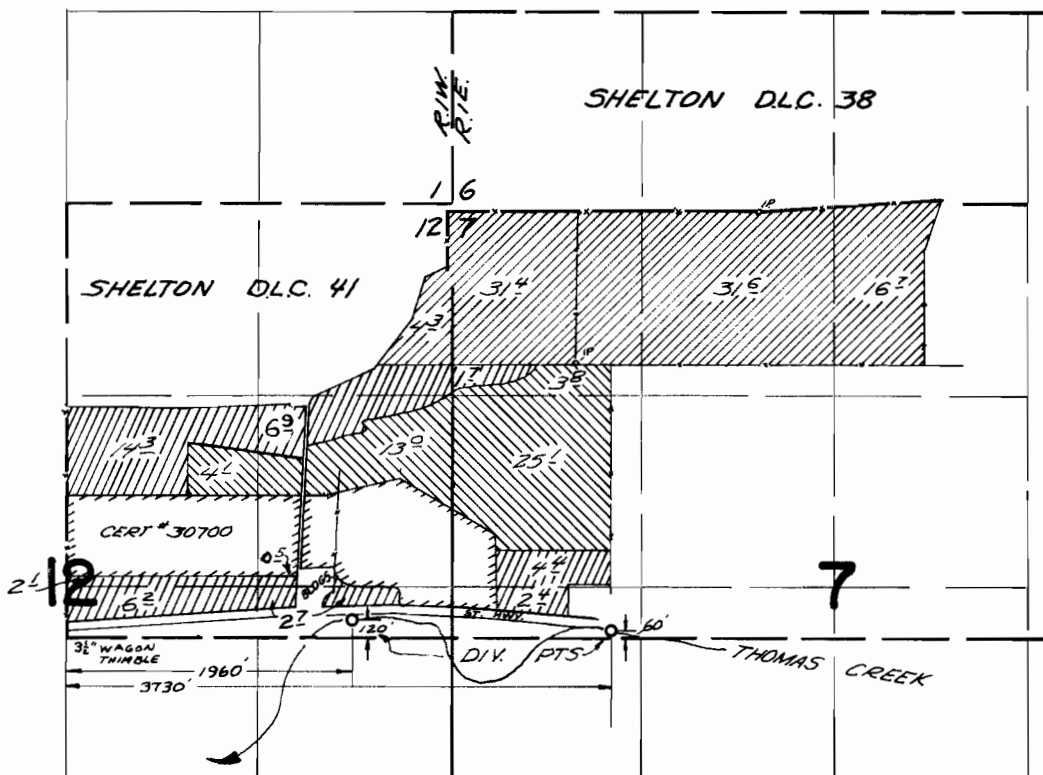

## FINAL PROOF SURVEY UNDER

	38483	28657	
	42066	31485	
Application No.	42550	Permit No.	31801

IN NAME OF

HAFCO INC.

Surveyed Nov. 6, 1968, by V. Garner