


T I O S. R. I E. W. M.

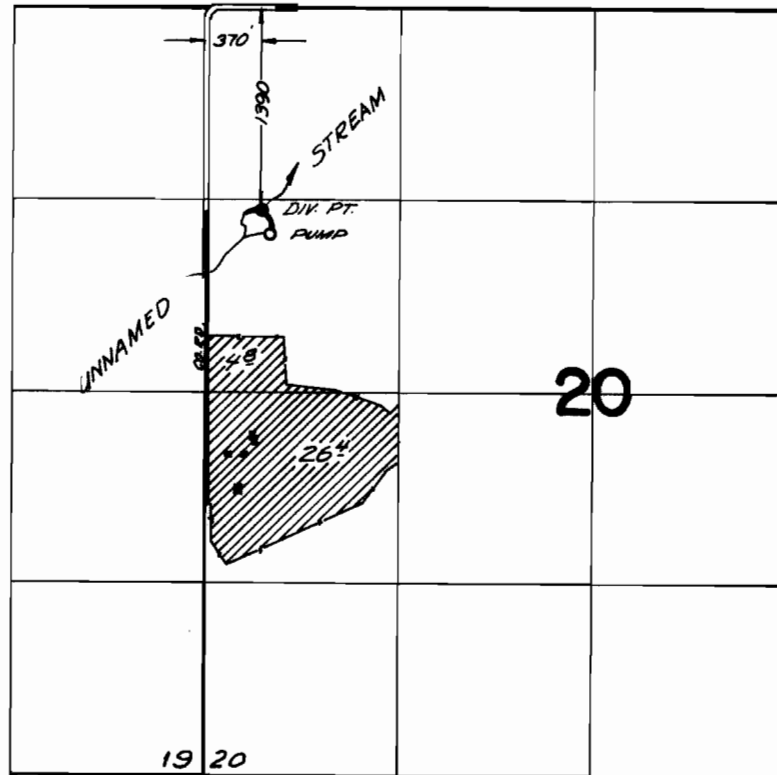

FINAL PROOF SURVEY
UNDER

Application No. *41974* Permit No. *31418*
IN NAME OF

ANTON and MARGARET ZURELUH

Surveyed *Sept 25, 1968*, by *V. Garner*