


T.14S. R.42E.W.M.

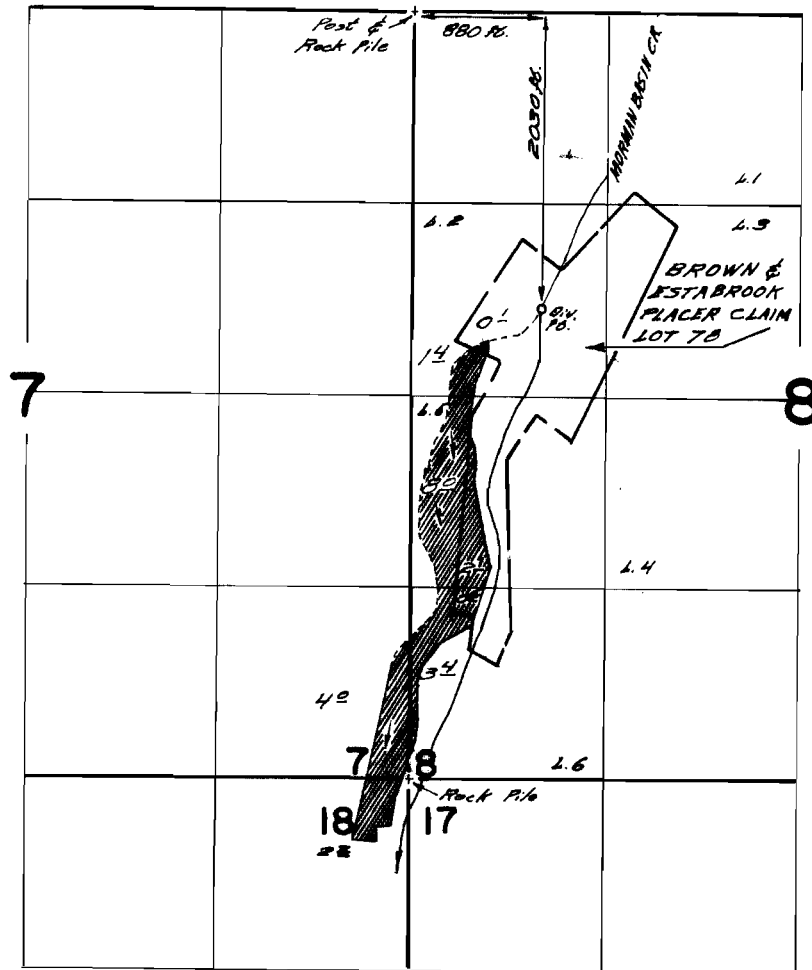

FINAL PROOF SURVEY
UNDER

Application No. 30706 Permit No. 24217
IN NAME OF

Horton & Philip Worsham

Surveyed June 14 1962 by C. Baker
Oct. 26, 67 W.C. Ruppert